

STATE ENGINEER
Salem, Oregon

MAR 6 1959

Well Record

STATE WELL NO. 5/1W-8D
COUNTY Marion
APPLICATION NO. GR-1346

GR- 1302

OWNER: William Howard Leighty


MAILING ADDRESS: Rt. 1, Box 13

LOCATION OF WELL: Owner's No.

CITY AND STATE: Woodburn, Oregon

NW 1/4 NW 1/4 Sec. 8 T. 5 S., R. 1 W., W.M.

Bearing and distance from section or subdivision corner 19.45 ch. E. & 13.45 ch. S. from NW cor. Section 8.

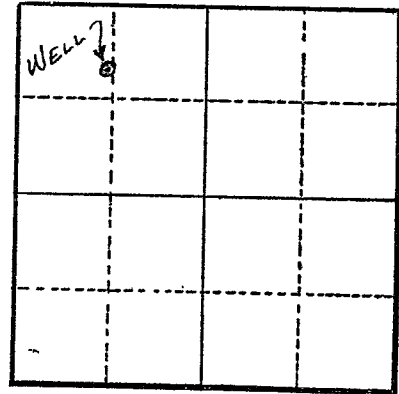

Section 8

Altitude at well 180

TYPE OF WELL: Drilled Date Constructed 1953

Depth drilled 140 ft. Depth cased 137 ft.

CASING RECORD:

8 inch

FINISH:

Perforated 114 to 137 ft.

AQUIFERS:

WATER LEVEL:

35 ft. (Fall)

PUMPING EQUIPMENT: Type Jacuzzi turbine
Capacity G.P.M.

H.P. 15

WELL TESTS:

Drawdown 60 ft. after hours 130 G.P.M.

Drawdown ft. after hours G.P.M.

USE OF WATER Irrigation Temp. °F, 19

SOURCE OF INFORMATION G. R. Record

DRILLER or DIGGER J. W. Beck

ADDITIONAL DATA:

Log N.A. Water Level Measurements Chemical Analysis Aquifer Test

REMARKS:

Irrigation of 21.78 acres.