

STATE ENGINEER
Salem, Oregon

~~0250~~
M.A.R.
16748

Well Record

GR- 1417

STATE WELL NO. 7/3W-1F
COUNTY Marion
APPLICATION NO. GR- 1468

OWNER: Elmer R. Fry


MAILING ADDRESS: 4605 Ridge Dr.

LOCATION OF WELL: Owner's No.

CITY AND STATE: Salem, Oregon

SE 1/4 NW 1/4 Sec. 1 T. 7 S. R. 3 W., W.M.

Bearing and distance from section or subdivision corner 1760' E. & 2497' S. from NW cor. Sec. 1

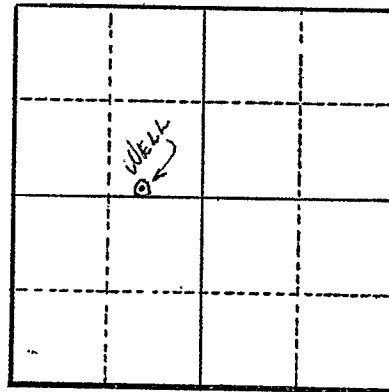

Section 1

Altitude at well 168' ? 155'

TYPE OF WELL: Drilled Date Constructed 1946

Depth drilled 68.5' Depth cased

CASING RECORD:

6"

FINISH:

AQUIFERS:

WATER LEVEL:

30'

PUMPING EQUIPMENT: Type Universal jet

H.P. 5

Capacity 80 G.P.M.

WELL TESTS:

Drawdown ft. after hours G.P.M.

Drawdown ft. after hours G.P.M.

USE OF WATER Irrigation Temp. °F. 19

SOURCE OF INFORMATION GR Record

DRILLER or DIGGER Chester Pugh

ADDITIONAL DATA:

Log N.A. Water Level Measurements Chemical Analysis Aquifer Test

REMARKS:

Irrigation of 5.2 acres