

STATE ENGINEER
Salem, Oregon

~~10747~~
10747
GR- 964
M.A.R.L.
Well Record


STATE WELL NO. 7/3W-1H(2)
COUNTY Marion
APPLICATION NO. GR- 996

OWNER: Paul C. Zielinski
MAILING ADDRESS: 2720 Blossom Drive

LOCATION OF WELL: Owner's No. #1
CITY AND STATE: Salem, Oregon

SE 1/4 NE 1/4 Sec. 1 T. 7 S., R. 3 W., W.M.

Bearing and distance from section or subdivision
corner 2100' S. & 300' W. from NE cor. Sec. 1.

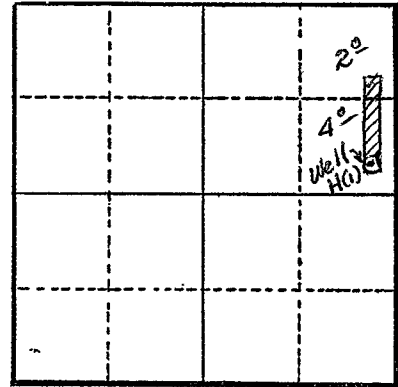

Section 1

Altitude at well 170'

TYPE OF WELL: Drilled Date Constructed 1952

Depth drilled 75 ft. Depth cased 75 ft.

CASING RECORD:

8 inch

FINISH:

Slot perforations from 70 to 75 ft.

AQUIFERS:

WATER LEVEL:

30 ft.

PUMPING EQUIPMENT: Type Berkeley turbine H.P. 5

Capacity 90 G.P.M.

WELL TESTS:

Drawdown ft. after hours G.P.M.

Drawdown ft. after hours G.P.M.

USE OF WATER Irrigation Temp. °F. 19

SOURCE OF INFORMATION G.R. Record

DRILLER or DIGGER Sneed Bros.

ADDITIONAL DATA:

Log N.A. Water Level Measurements Chemical Analysis Aquifer Test

REMARKS:

Irrigation of 6 acres.