

B 10f2

STATE ENGINEER  
Salem, Oregon

# Well Record

STATE WELL NO. 7/3W-1R  
COUNTY Marion  
APPLICATION NO. GR-2653

marion  
16748

OWNER: George Gideon Strozut, Sr.

MAILING ADDRESS: 4640 Portland Road, N.E.

LOCATION OF WELL: Owner's No.

CITY AND STATE: Salem, Oregon

SE 1/4 SE 1/4 Sec. 1 T. 7 N S, R. 3 W, W.M.

Bearing and distance from section or subdivision corner N. 3.30 chs. & W. 7.70 chs.


Altitude at well

TYPE OF WELL: drilled Date Constructed 1937

Depth drilled 85' Depth cased 85'

Section

### CASING RECORD:

6 inch

### FINISH:

AQUIFERS: clay, soil, water, sand and gravel

WATER LEVEL: 40 feet

PUMPING EQUIPMENT: Type Advance Jet H.P. 1  
Capacity 30 G.P.M.

WELL TESTS: 1000 gal. per hour, without lowering water level  
Drawdown ft. after hours G.P.M.  
Drawdown ft. after hours G.P.M.

USE OF WATER irrigation Temp. °F. 19

SOURCE OF INFORMATION GR-2515

DRILLER or DIGGER J. A. Sneed & Sons, 2505 Brooks St., Salem, Oregon

ADDITIONAL DATA:  
Log  Water Level Measurements  Chemical Analysis  Aquifer Test

REMARKS: Clay and Soil 0 to 58  
water and sand 58 to 75  
water bearing gravel 75 to 85

STATE ENGINEER  
Salem, Oregon

# Well Record

STATE WELL NO. 7/3W-1B(1)  
COUNTY Marion  
APPLICATION NO. \_\_\_\_\_

*mari*  
*16748*


*Pg 2 of 2*

OWNER: G. G. Strozut, Jr.

MAILING ADDRESS: \_\_\_\_\_  
CITY AND STATE: \_\_\_\_\_

LOCATION OF WELL: Owner's No. \_\_\_\_\_

\_\_\_\_\_  $\frac{1}{4}$  \_\_\_\_\_  $\frac{1}{4}$  Sec. \_\_\_\_\_ T. \_\_\_\_\_ N. S., R. \_\_\_\_\_ E. W., W.M.  
Bearing and distance from section or subdivision corner \_\_\_\_\_

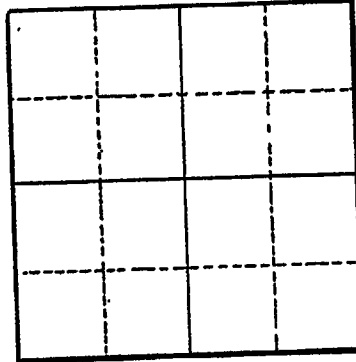

Section \_\_\_\_\_

Altitude at well \_\_\_\_\_ 183

TYPE OF WELL: Drilled Date Constructed 1937

Depth drilled 85 Depth cased 85

CASING RECORD:

6 inch

FINISH:

AQUIFERS:

WATER LEVEL:  
40 feet

PUMPING EQUIPMENT: Type Jet H.P. 1  
Capacity \_\_\_\_\_ G.P.M.

WELL TESTS:  
Drawdown \_\_\_\_\_ ft. after \_\_\_\_\_ hours \_\_\_\_\_ G.P.M.  
Drawdown \_\_\_\_\_ ft. after \_\_\_\_\_ hours \_\_\_\_\_ G.P.M.

USE OF WATER Domestic, Irrigation-4 acres Temp. \_\_\_\_\_ °F. \_\_\_\_\_, 19\_\_\_\_  
SOURCE OF INFORMATION USGS

DRILLER or DIGGER \_\_\_\_\_  
ADDITIONAL DATA:

Log \_\_\_\_\_ Water Level Measurements \_\_\_\_\_ Chemical Analysis \_\_\_\_\_ Aquifer Test \_\_\_\_\_

REMARKS: