

STATE ENGINEER
Salem, Oregon

~~0200~~ Well Record

STATE WELL NO. 7/3W-1H
COUNTY MARTON
APPLICATION NO. GR-2733

MARI.....

16753

P 2 of 3

OWNER: Raymond Nekuda


MAILING ADDRESS: 2555 Blossom Drive

LOCATION OF WELL: Owner's No.

CITY AND STATE: Salem, Oregon

SE 1/4 NE 1/4 Sec. 1 T. 7 N. S., R. 3 E. W., W.M.

Bearing and distance from section or subdivision corner 1150' N. and 1220' W.

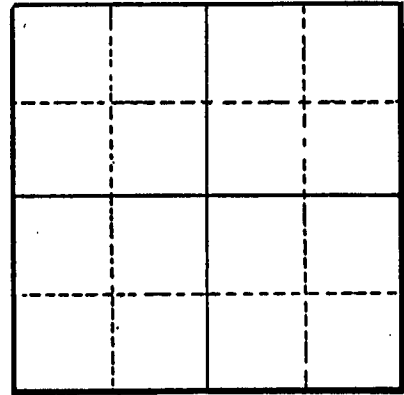

Section

Altitude at well

TYPE OF WELL: drilled. Date Constructed 1949

Depth drilled 100 Depth cased 100

CASING RECORD:

8-inch

FINISH:

64 from 38 to 45
Mills knife 3/8 x 2 1/2 80 from 54 to 62
168 from 68 to 89
40 from 95 to 100

AQUIFERS:

Clay, sand, gravel

WATER LEVEL:

20-feet

PUMPING EQUIPMENT: Type Peerless Turbine H.P. 10
Capacity 225 G.P.M.

WELL TESTS:

Drawdown 40 ft. after hours Pumping 217 G.P.M.
Drawdown ft. after hours G.P.M.

USE OF WATER Temp. °F., 19

SOURCE OF INFORMATION GR-2586

DRILLER or DIGGER Duffield Brothers

ADDITIONAL DATA:

Log X Water Level Measurements Chemical Analysis Aquifer Test

REMARKS:

