

STATE ENGINEER
Salem, Oregon

~~MAR 1949~~ Well Record
16767
MAR

STATE WELL NO. 7/3W-1P
COUNTY Marion
APPLICATION NO. GR-3311

OWNER: Edw. L. McCloud


MAILING ADDRESS: 1985 Claxter Road

LOCATION OF WELL: Owner's No.

CITY AND STATE: Salem, Oregon

SE 1/4 SW 1/4 Sec. 1 T. 7 S. R. 3 W., W.M.

Bearing and distance from section or subdivision
corner 235' NE of intersection of Claxter Rd.
and Ridge Drive

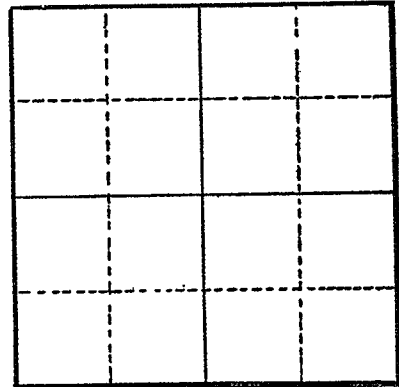

Section

Altitude at well

TYPE OF WELL: drilled Date Constructed 1949

Depth drilled 55' Depth cased 55'

CASING RECORD:

6"

FINISH:

Last 5' of casing perforated

AQUIFERS:

WATER LEVEL:

30'

PUMPING EQUIPMENT: Type Jacuzzi deep-well jet H.P. 3
Capacity 60 G.P.M.

WELL TESTS:

Drawdown ft. after hours pumping 45 G.P.M.
Drawdown ft. after hours G.P.M.

USE OF WATER irrigation Temp. °F., 19

SOURCE OF INFORMATION GR-3073

DRILLER or DIGGER Fred Wymore, Route 2, Salem, Oregon

ADDITIONAL DATA:

Log Water Level Measurements Chemical Analysis Aquifer Test

REMARKS: