

STATE ENGINEER  
Salem, Oregon

**Well Record**

STATE WELL NO. 7/3W-20(2) <sup>cde</sup>  
COUNTY Marion  
APPLICATION NO. GR-24

*M.A.R. ....*


*10800*  
*16800*  
*MAR*

OWNER: Manbrin Gardens, Inc. MAILING ADDRESS: Box 48

LOCATION OF WELL: Owner's No. Toni Well CITY AND STATE: Salem, Oregon

SW 1/4 SW 1/4 Sec. 2 T. 7 S. R. 3 W., W.M.

Bearing and distance from section or subdivision corner Lot 6, Block 2, Manbrin Gardens, NW corner of lot.

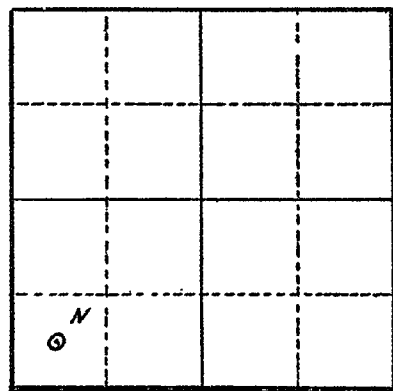

Section 2

Altitude at well 132 feet interpolated

TYPE OF WELL: Drilled Date Constructed Jan. 1947, '43?

Depth drilled 135 feet Depth cased 130 feet

CASING RECORD:

12-inch casing set from 0 to 130 feet #25 casing

FINISH:

3/8" perforations set from 20' to 135' having 12 perf./foot

AQUIFERS:

gravels from 55' to 135'

WATER LEVEL:

55' ~~55'~~ land surface Feb. 1947

PUMPING EQUIPMENT: Type Berkeley Turbine H.P. 25  
Capacity 500 G.P.M.

WELL TESTS: 99 ?  
Drawdown 44 ft. after hours 440 G.P.M.  
Drawdown ft. after hours G.P.M.

USE OF WATER Municipal Temp. °F., 19

SOURCE OF INFORMATION GR-20; GR-3069, Conf. GR-2872

DRILLER or DIGGER A.M. Jansen

ADDITIONAL DATA:

Log  Water Level Measurements Chemical Analysis Aquifer Test

REMARKS:

