

STATE ENGINEER
Salem, Oregon

16812
MARI

Well Record


cc
STATE WELL NO. 7/3W-272
COUNTY Marion
APPLICATION NO. GR-3069

OWNER: The Keizer Water District

MAILING ADDRESS: 3425 River Road N. E.
CITY AND STATE: Salem, Oregon

LOCATION OF WELL: Owner's No. Toni Well #5
SW 1/4 SW 1/4 Sec. 2 T. 7 N. S. R. 3 E. W., W.M.

Bearing and distance from section or subdivision corner Lot 6, Block 2 of Manbrin Gardens

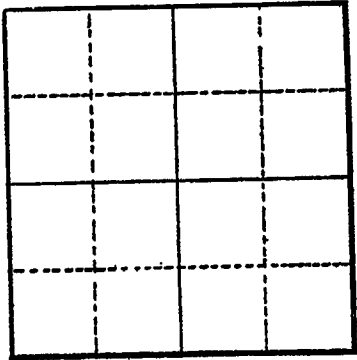

Dupl.

Altitude at well

TYPE OF WELL: Drilled Date Constructed 1943

Depth drilled 135 feet Depth cased 135 feet

Section

CASING RECORD:
12-inch

FINISH:

AQUIFERS:
Sand and Gravel

WATER LEVEL:
20 feet

PUMPING EQUIPMENT: Type Lane bowler Turbine H.P. 25
Capacity _____ G.P.M.

WELL TESTS:
Drawdown 99 ft. after _____ hours Pumping 140 G.P.M.
Drawdown _____ ft. after _____ hours _____ G.P.M.

USE OF WATER Municipal water district Temp. _____ °F. _____, 19____

SOURCE OF INFORMATION GR-2872
DRILLER or DIGGER A. M. Jensen

ADDITIONAL DATA:
Log Water Level Measurements _____ Chemical Analysis _____ Aquifer Test _____

REMARKS:
Sand and gravel

STATE ENGINEER
Salem, Oregon

MAR
16812

Well Record

STATE WELL NO. ^{26c} 7/3W-28(2)
COUNTY Marion
APPLICATION NO. _____

OWNER: The Keizer Water District


MAILING ADDRESS: _____
B 2 of 3

LOCATION OF WELL: Owner's No. _____

CITY AND STATE: _____

..... 1/4 1/4 Sec. T. N. E.
S., R. W., W.M.

Bearing and distance from section or subdivision
corner _____

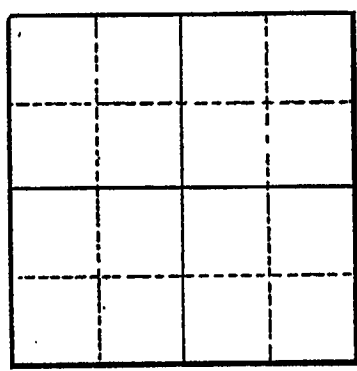

Altitude at well 132

TYPE OF WELL: Drilled Date Constructed 1946

Depth drilled 134 Depth cased 135 1/2

Section _____

CASING RECORD:
12 inch

FINISH:
Casing perforated 130 to 135 1/2

AQUIFERS:
Gravel from 112 to 134

WATER LEVEL:
20 feet below land surface on January 23, 1947

PUMPING EQUIPMENT: Type Turbine H.P. 25
Capacity _____ G.P.M.

WELL TESTS:
Drawdown _____ ft. after _____ hours _____ G.P.M.
Drawdown _____ ft. after _____ hours _____ G.P.M.

USE OF WATER Public Supply Temp. _____ °F. 19

SOURCE OF INFORMATION USGS GR-2872

DRILLER or DIGGER _____
ADDITIONAL DATA:
Log Water Level Measurements _____ Chemical Analysis _____ Aquifer Test _____

REMARKS:

