

258
STATE ENGINEER
Salem, Oregon

Well Record
MARION COUNTY
16813
MARION

STATE WELL NO. 7/3W-2A(2)
COUNTY Marion
APPLICATION NO.


OWNER: The Keizer Water District

MAILING ADDRESS:
CITY AND STATE:

LOCATION OF WELL: Owner's No.

1/4 1/4 Sec. T. N. E. S, R. W., W.M.

Bearing and distance from section or subdivision corner

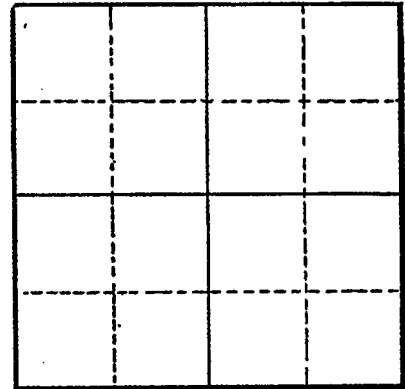

Altitude at well 132

TYPE OF WELL: Drilled Date Constructed 1946

Depth drilled 134 Depth cased 135 1/2

Section

CASING RECORD:

12 inch

FINISH:

Casing perforated 130 to 135 1/2

AQUIFERS:

Gravel from 112 to 134

WATER LEVEL:

20 feet below land surface on January 23, 1947

PUMPING EQUIPMENT: Type Turbine H.P. 25
Capacity G.P.M.

WELL TESTS:

Drawdown ft. after hours G.P.M.
Drawdown ft. after hours G.P.M.

USE OF WATER Public Supply Temp. °F., 19

SOURCE OF INFORMATION USGS GR-2872

DRILLER or DIGGER

ADDITIONAL DATA:

Log X Water Level Measurements Chemical Analysis Aquifer Test

REMARKS:

