

STATE ENGINEER
Salem, Oregon

Well Record

STATE WELL NO. 7/3W-2G(1)
COUNTY Marion
APPLICATION NO. GR-1224


MAR... 1184
MAR 1951

OWNER: Ernest E. Porter MAILING ADDRESS: 4852 Rickman Rd.

LOCATION OF WELL: Owner's No. _____ CITY AND STATE: Salem, Oregon

SW 1/4 NE 1/4 Sec. 2 T. 7 S., R. 3 W., W.M.

Bearing and distance from section or subdivision corner 1750' W. & 1600' S. from NE cor. Sec. 2.

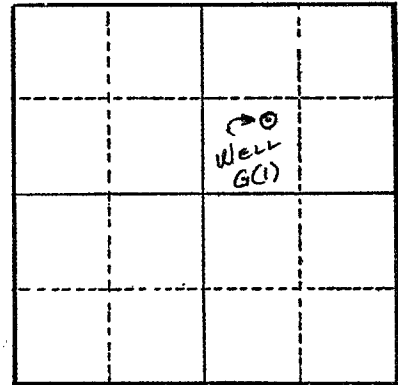

Section 2

Altitude at well 125 ft.

TYPE OF WELL: Drilled Date Constructed 1951

Depth drilled 44 ft. Depth cased 44 ft.

CASING RECORD:

8 inch

FINISH:

3 sets of 4 slots 8 in. long from 38 to 44 ft.

AQUIFERS:

WATER LEVEL:

9 ft. --- 4 ft. in March 1958

PUMPING EQUIPMENT: Type Cent. H.P. 3

Capacity 80 to 100 G.P.M.

WELL TESTS:

Drawdown _____ ft. after _____ hours _____ G.P.M.

Drawdown _____ ft. after _____ hours _____ G.P.M.

USE OF WATER Irrigation Temp. _____ °F. _____, 19_____

SOURCE OF INFORMATION G. R. Record

DRILLER or DIGGER Fred Wymore

ADDITIONAL DATA:

Log _____ Water Level Measurements _____ Chemical Analysis _____ Aquifer Test _____

REMARKS:

Log: Top soil 0 to 9 ft.
Gravel 9 to 44 ft.

Irrigation of 4.5 acres.