

STATE ENGINEER
Salem, Oregon

MAR 16826

Well Record

STATE WELL NO. 7/3W-2L(2)
COUNTY Marion
APPLICATION NO.

MAR 16826
MAR 16826

OWNER: The Keizer Water District


MAILING ADDRESS:

LOCATION OF WELL: Owner's No.

CITY AND STATE:

1/4 Sec. T. N. S., R. E. W., W.M.

Bearing and distance from section or subdivision corner

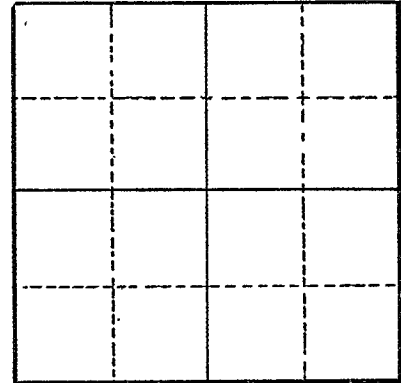

Section

Altitude at well 130

TYPE OF WELL: Drilled Date Constructed 1946

Depth drilled 135 Depth cased 135

CASING RECORD:

8 inch

FINISH:

Casing perforated

AQUIFERS:

WATER LEVEL:

21 feet below land surface, 1946

PUMPING EQUIPMENT: Type Turbine H.P. 5
Capacity G.P.M.

WELL TESTS:

Drawdown ft. after hours G.P.M.
Drawdown ft. after hours G.P.M.

USE OF WATER Public Supply Temp. °F., 19

SOURCE OF INFORMATION USGS

DRILLER or DIGGER

ADDITIONAL DATA:

Log Water Level Measurements Chemical Analysis Aquifer Test

REMARKS:

Hardness 75 p.p.m.
Chloride 8 p.p.m.

OREGON HEALTH DIVISION ONLY

Received Date:

County Well Log ID #

9/18/00

MARI 16826

MARI 16778

MARI 16772

WELL IDENTIFICATION LABEL ATTACHMENT FORM
(OREGON HEALTH DIVISION)

COMPANY / CURRENT WELL OWNER:

OWNER (S) WELL NO: #1

Name: City of Keizer

Mailing Address: P.O. Box 21000

City: Keizer State: OR Zip: 97307 Phone: (503) 390-3700

CONTACT PERSON:

NAME: Joe Edgell PHONE # (503) 390-3700

THIS FORM IS ONLY TO BE USED FOR WELLS WITH
POSITIVELY IDENTIFIED
WATER SUPPLY WELL REPORTS.

O.H.D. OFFICIAL USE ONLY

TOWNSHIP: 7 N RANGE: 3 E SECTION: 2 TAX LOT: 20

Well Identification Label: L-32101

LABEL ATTACHED BY: Tom Patten DATE: 8/18/00
(O.H.D. OFFICIAL)

(WATER SUPPLY WELL REPORT MUST BE ATTACHED!)

Please Return Completed Form to:

Larry D. McQueen
Well Identification Program
Oregon Water Resources Department
158 17th Street NE
Salem, OR 97310