

STATE ENGINEER
Salem, Oregon

Well Record

STATE WELL NO. 7/3W-2N
COUNTY Marion
APPLICATION NO. GR-3112

OWNER: The Keizer Water District


MAILING ADDRESS: 3425 River Road N.

LOCATION OF WELL: Owner's No.

CITY AND STATE: Salem, Oregon

SW 1/4 SW 1/4 Sec. 2 T. 7 N. S. R. 3 E. W. W.M.

Bearing and distance from section or subdivision corner 890' N. and 100' E.

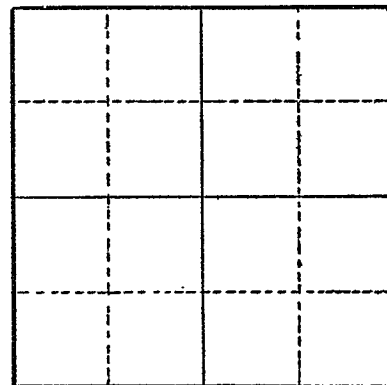

Section

Altitude at well

TYPE OF WELL: drilled Date Constructed 1954

Depth drilled 120' Depth cased 120'

CASING RECORD:

8"

FINISH:

AQUIFERS:

WATER LEVEL:

PUMPING EQUIPMENT: Type Universal H.P. 5
Capacity 150? G.P.M.

WELL TESTS:

Drawdown ft. after hours G.P.M.
Drawdown ft. after hours G.P.M.

USE OF WATER Municipal water supply Temp. °F. 19
SOURCE OF INFORMATION GR-3160

DRILLER or DIGGER

ADDITIONAL DATA:

Log Water Level Measurements Chemical Analysis Aquifer Test

REMARKS: