

STATE ENGINEER
Salem, Oregon

16829
MARION
Well Record
16829
MARION


STATE WELL NO. 7/3W-2N(6)
COUNTY Marion
APPLICATION NO.

OWNER: The Keizer Water District MAILING ADDRESS:

LOCATION OF WELL: Owner's No. CITY AND STATE:

1/4 1/4 Sec. T. N. S., R. E. W., W.M.

Bearing and distance from section or subdivision
corner

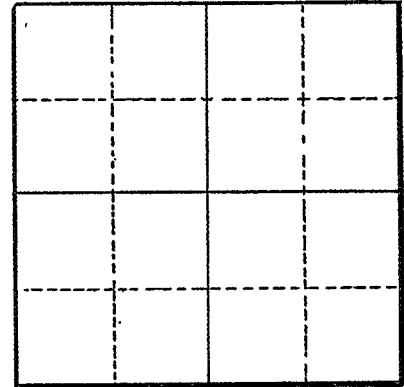

Section

Altitude at well 132

TYPE OF WELL: Drilled Date Constructed 1954

Depth drilled 120 Depth cased

CASING RECORD:

8 inch

FINISH:

AQUIFERS:

WATER LEVEL:

PUMPING EQUIPMENT: Type Turbine H.P. 5
Capacity G.P.M.

WELL TESTS:
Drawdown ft. after hours G.P.M.
Drawdown ft. after hours G.P.M.

USE OF WATER Public Supply Temp. °F. 19

SOURCE OF INFORMATION USGS

DRILLER or DIGGER

ADDITIONAL DATA:
Log Water Level Measurements Chemical Analysis Aquifer Test

REMARKS: