

STATE ENGINEER
Salem, Oregon

Well Record

STATE WELL NO. 7/3W-3D(2)
COUNTY Marion
APPLICATION NO. GR-656

MAR 16852
MAR

OWNER: William M. Murphy


MAILING ADDRESS: 195 West Chem

LOCATION OF WELL: Owner's No. # 1

CITY AND STATE: Salem, Oregon

NW 1/4 NW 1/4 Sec. 3 T. 7 S., R. 3 W., W.M.

Bearing and distance from section or subdivision corner 1120 feet East and 290 feet South of NW corner, Section 3.

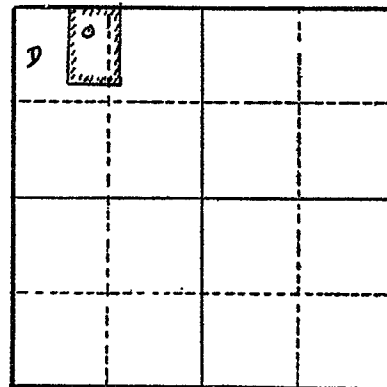

Altitude at well

TYPE OF WELL: Drilled Date Constructed Oct. 8, 1951

Depth drilled 44 Depth cased 44

Section 3

CASING RECORD:

8-inch

FINISH:

AQUIFERS:

WATER LEVEL:

25 feet

PUMPING EQUIPMENT: Type Berkeley Turbine H.P. 5
Capacity 100 G.P.M.

WELL TESTS:

Drawdown 1/2 ft. after 450 hours G.P.M.
Drawdown ft. after hours G.P.M.

USE OF WATER Irrigation 12 Temp. °F. 19

SOURCE OF INFORMATION GR-624

DRILLER or DIGGER

ADDITIONAL DATA:

Log X Water Level Measurements Chemical Analysis Aquifer Test

REMARKS:

Sandy loam	0	20	20
Water bearing sand and gravel	20	41	21
Cemented gravel (hardpan)	41	42.5	1.5
Water-bearing sand and gravel	42.5	44	1.5