

ORIGINAL
File Original and
Duplicate with the
STATE ENGINEER,
SALEM, OREGON

7/3W-3D(1)
mar
16853

WATER WELL REPORT
STATE OF OREGON

State Well No. 7/3W-3D(1)
16853
State Permit No. 6A

(1) OWNER:

Name ALBY STAIN
Address 1180 CALVERT ST.

(11) WELL TESTS:

Drawdown is amount water level is lowered below static level
Was a pump test made? Yes No If yes, by whom? By 2 of 2
Yield: 150 gal./min. with 12 ft. drawdown after 4 hrs.

(2) LOCATION OF WELL:

County _____ Owner's number, if any—
X 1/4 1/4 Section T. R. W.M.
Bearing and distance from section or subdivision corner

Bailer test gal./min. with ft. drawdown after hrs.

Artesian flow g.p.m. Date

Temperature of water Was a chemical analysis made? Yes No

(3) TYPE OF WORK (check):

New Well Deepening Reconditioning Abandon
If abandonment, describe material and procedure in Item 11.

(4) PROPOSED USE (check):

Domestic Industrial Municipal
Irrigation Test Well Other

(5) TYPE OF WELL:

Rotary Driven
Cable Jetted
Dug Bored

(6) CASING INSTALLED:

Threaded Welded
" Diam. from ft. to ft. Gage _____
8" Diam. from 1 ft. to 55 ft. Gage 70

(7) PERFORATIONS:

Perforated? Yes No
Type of perforator used Mills
SIZE of perforations 5/8 x 1 1/8 in. by _____ in.
~~5/8~~ perforations from _____ ft. to _____ ft.
544 perforations from 21 ft. to 55 ft.
perforations from _____ ft. to _____ ft.
perforations from _____ ft. to _____ ft.

(8) SCREENS:

Well screen installed Yes No
Manufacturer's Name _____ Model No. _____
Type _____
Diam. _____ Slot size _____ Set from _____ ft. to _____ ft.
Diam. _____ Slot size _____ Set from _____ ft. to _____ ft.

(9) CONSTRUCTION:

Was well gravel packed? Yes No Size of gravel: _____
Gravel placed from _____ ft. to _____ ft.
Was a surface seal provided? Yes No To what depth? _____ ft.
Material used in seal—
Did any strata contain unusable water? Yes No
Type of water? _____ Depth of strata _____
Method of sealing strata off _____

(10) WATER LEVELS:

Static level 18 ft. below land surface Date DEC 22
Artesian pressure _____ lbs. per square inch Date _____

Log Accepted by:

X [Signed] _____ Date _____, 19____
(Owner)

(12) WELL LOG:

Diameter of well 8 inches.
Depth drilled 55 ft. Depth of completed well 55 ft.

Formation: Describe by color, character, size of material and structure, and show thickness of aquifers and the kind and nature of the material in each stratum penetrated, with at least one entry for each change of formation.

MATERIAL	FROM	TO
TOP SOIL	1	3
CLAY	3	19
SAND-GRAVEL	19	35
HARD PAN	35	42
GRAVEL	42	55

Work started MAY 7 1955 Completed MAY 12 1955

(13) PUMP:

Manufacturer's Name _____
Type: _____ H.P. _____

Well Driller's Statement:

This well was drilled under my jurisdiction and this report is true to the best of my knowledge and belief.

NAME H. R. MILLER
(Person, firm, or corporation) (Type or print)

Address 5620 SUNNYVIEW

Driller's well number 792

[Signed] H. R. Miller
(Well Driller)

License No. 37 Date DEC 28, 1957

STATE ENGINEER
Salem, Oregon

Mari
16853

Well Record

STATE WELL NO. *7/3W-3D(3)*
COUNTY *Marion*
APPLICATION NO. *GR-1049*

3R 1011

OWNER: *Alex Stein*


MAILING ADDRESS: *1180 Claggett St. P 1 of 2*

LOCATION OF WELL: Owner's No. _____

CITY AND STATE: *Salem, Oregon*

NW 1/4 *NW* 1/4 Sec. *3* T. *7* S., R. *3* W., W.M.

Bearing and distance from section or subdivision corner *500' S. & 500' E. from NW cor. Sec. 3.*

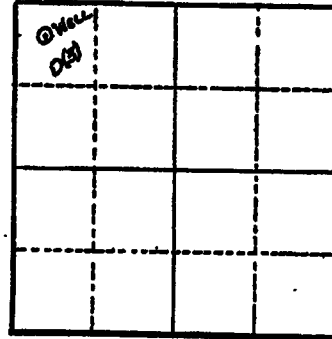

Section *3*

Altitude at well *130 ft.*

TYPE OF WELL: *Drilled* Date Constructed *1955*

Depth drilled *55 ft.* Depth cased *55 ft.*

CASING RECORD:

8 inch

FINISH:

Mill knife perforations (16) from 21 to 52 ft.

AQUIFERS:

WATER LEVEL:

18 ft. (12-28-57)

PUMPING EQUIPMENT: Type *Jacuzzi Turbine* HP. *7 1/2*
Capacity *150* G.P.M.

WELL TESTS:

Drawdown *12* ft. after _____ hours *150* G.P.M.

Drawdown _____ ft. after _____ hours _____ G.P.M.

USE OF WATER *Irrigation* Temp. _____ °F. _____, 19____

SOURCE OF INFORMATION *G.R. Record*

DRILLER or DIGGER *H. R. Miller*

ADDITIONAL DATA:

Log _____ Water Level Measurements _____ Chemical Analysis _____ Aquifer Test _____

REMARKS:

Log: Top soil	0 to 3 ft.
Clay	3 to 19 ft.
Sand & gravel	19 to 35 ft.
Hard pan	35 to 42 ft.
Gravel	42 to 55 ft.

Irrigation of 10 acres.