

STATE ENGINEER
Salem, Oregon

Well Record

STATE WELL NO. 7/3W-10H(1)
COUNTY Marion
APPLICATION NO. GR-1565


MARI...
MARI 16903 GR-1507

OWNER: Wayne L. Weeks (Weeks Berry Nursery) MAILING ADDRESS: 3495 N. River Rd.

LOCATION OF WELL: Owner's No. #1 CITY AND STATE: Salem, Oregon

SE 1/4 NE 1/4 Sec. 10 T. 7 S., R. 3 W., W.M.

Bearing and distance from section or subdivision corner 2870' N. & 480' W. from SE cor. Sec. 10

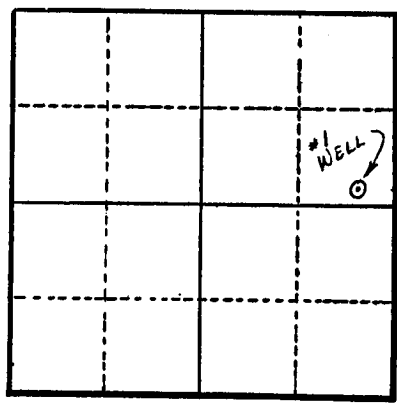

Section 10

Altitude at well 145'

TYPE OF WELL: Drilled Date Constructed 1945

Depth drilled 51' Depth cased 51'

CASING RECORD:
8"

FINISH:
Perforated from 16 to 42 ft. (Estimated)

AQUIFERS:
Sand & gravel

WATER LEVEL:
17' 20' 1946

PUMPING EQUIPMENT: Type Berkeley 1 1/2" turbine H.P. 10
Capacity 175 G.P.M. *vertical?*

WELL TESTS:
Drawdown 8 ft. after 180 hours G.P.M.
Drawdown ft. after hours G.P.M.

USE OF WATER Irrigation Temp. °F. 19

SOURCE OF INFORMATION GR Record

DRILLER or DIGGER Wymore Bros.
ADDITIONAL DATA:
Log N.A. Water Level Measurements Chemical Analysis Aquifer Test

REMARKS:
Irrigation of 21 acres.