

STATE ENGINEER
Salem, Oregon

~~16911~~
M 1 21
16911
MAR
Well Record


STATE WELL NO. 7/3W-11G
COUNTY: MARION
APPLICATION NO. GR-2703

OWNER: Lewis Welch and Lula Welch
MAILING ADDRESS: 1208 Candlewood Drive

LOCATION OF WELL: Owner's No.
CITY AND STATE: Salem, Oregon

SW 1/4 NE 1/4 Sec. 11 T. 7 N. S. R. 3 W. W.M.

Bearing and distance from section or subdivision corner 450' E. and 100' N.

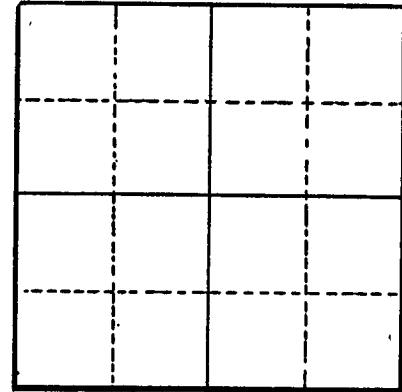

Section

Altitude at well

TYPE OF WELL: drilled Date Constructed 1955

Depth drilled 42 Depth cased 40

CASING RECORD:

6-inch

FINISH:

Perforated near bottom

AQUIFERS:

WATER LEVEL:

13-feet

PUMPING EQUIPMENT: Type Sears Jet H.P. 1
Capacity 21 G.P.M.

WELL TESTS:

Drawdown ft. after hours G.P.M.

Drawdown ft. after hours G.P.M.

USE OF WATER Irrigation Temp. °F., 19

SOURCE OF INFORMATION GR-2561

DRILLER or DIGGER Harlan Miller

ADDITIONAL DATA:

Log Water Level Measurements Chemical Analysis Aquifer Test

REMARKS: