

STATE ENGINEER
Salem, Oregon

~~Well Record~~
Well Record
MARION 16912
MARION


STATE WELL NO. 7/3W-11G
COUNTY MARION
APPLICATION NO. GR-3145

OWNER: J. Henry and Cora Peden MAILING ADDRESS: 1190 Shady Lane

LOCATION OF WELL: Owner's No. CITY AND STATE: Salem

SW 1/4 NE 1/4 Sec. 11 T. 7 S., R. 3 W., W.M.

Bearing and distance from section or subdivision corner about 2390' W & 710' N from E 1/4 corner Sect 11

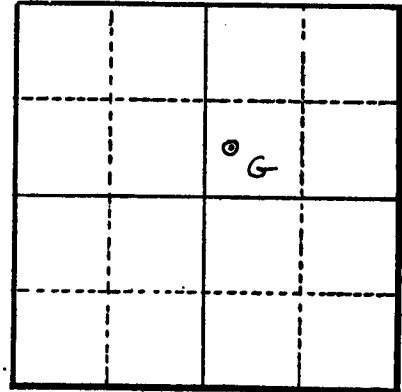

Section 11

Altitude at well

TYPE OF WELL: Driven Date Constructed 1950

Depth drilled 20' Depth cased 20'

CASING RECORD:

FINISH:

AQUIFERS: soil, gravel, sand

WATER LEVEL: 11'

PUMPING EQUIPMENT: Type Universal H.P. Capacity 20 G.P.M.

WELL TESTS: Drawdown 8 ft. after 20 hours G.P.M. Drawdown ft. after hours G.P.M.

USE OF WATER Irrigation Temp. °F. 19

SOURCE OF INFORMATION GR-3891

DRILLER or DIGGER

ADDITIONAL DATA: Log ^x Water Level Measurements Chemical Analysis Aquifer Test

REMARKS:

Soil 10', gravel and sand 10'