

STATE ENGINEER
Salem, Oregon

Well Record

STATE WELL NO. 7/3W-11F
COUNTY Marion
APPLICATION NO. GR-3275

MARI.....

16914
MARI

OWNER: Vaughn L. Foote


MAILING ADDRESS: 3810 Cherry Avenue

LOCATION OF WELL: Owner's No.

CITY AND STATE: Salem, Oregon

SE 1/4 NW 1/4 Sec. 11 T. 7 S., R. 3 W., W.M.

Bearing and distance from section or subdivision corner 1950' E. & 1650' S. from NW cor. Sec. 11

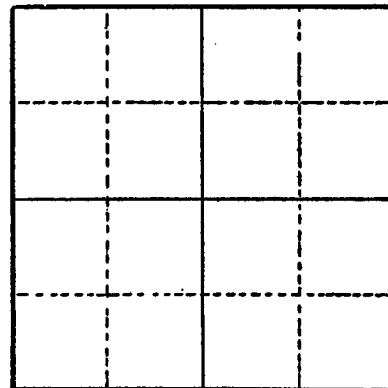

Section

Altitude at well

TYPE OF WELL: drilled Date Constructed 1946

Depth drilled 60 Depth cased 60

CASING RECORD:

6 inch

FINISH:

AQUIFERS:

WATER LEVEL:

PUMPING EQUIPMENT: Type Wards Jet H.P. 3/4
Capacity 26 G.P.M.

WELL TESTS:
Drawdown ft. after hours G.P.M.
Drawdown ft. after hours G.P.M.

USE OF WATER Irrigation Temp. °F., 19.....

SOURCE OF INFORMATION CR3045

DRILLER or DIGGER

ADDITIONAL DATA:

Log Water Level Measurements Chemical Analysis Aquifer Test

REMARKS: