

MARI 16919

STATE ENGINEER
Salem, Oregon

Well Record

STATE WELL NO. 7/3W-11D
COUNTY Marion
APPLICATION NO. GR-3300

MARI 16919
MARI

OWNER: G. Royal Boltman

MAILING ADDRESS: 3905 River Road

LOCATION OF WELL: Owner's No.

CITY AND STATE: North Salem, Oregon

NW 1/4 NW 1/4 Sec. 11 T. 7 N. S. R. 3 E. W., W.M.

Bearing and distance from section or subdivision
corner 2445.4' S., 324.8' W. from NE cor. T. D.
Keizer DLC 38

Section

Altitude at well

TYPE OF WELL: drilled Date Constructed 1939

Depth drilled 60 Depth cased 60

CASING RECORD:

6 inch

FINISH:

AQUIFERS:

WATER LEVEL:

35 feet

PUMPING EQUIPMENT: Type Pacific Pumping Co. Jet H.P. 1
Capacity 15 G.P.M.

WELL TESTS:

Drawdown ft. after hours G.P.M.
Drawdown ft. after hours G.P.M.

USE OF WATER Irrigation Temp. °F., 19

SOURCE OF INFORMATION GR-3062

DRILLER or DIGGER

ADDITIONAL DATA:

Log Water Level Measurements Chemical Analysis Aquifer Test

REMARKS:

Mari
16919

MARI 16919

STATE ENGINEER
Salem, Oregon

Well Record

STATE WELL NO. 7/3W-11D(?)
COUNTY Marion
APPLICATION NO.

OWNER: G. R. Boltman


MAILING ADDRESS: P3 20F 2

LOCATION OF WELL: Owner's No.

CITY AND STATE:

..... 1/4 1/4 Sec. T. N. E.
S, R. W., W.M.

Bearing and distance from section or subdivision corner

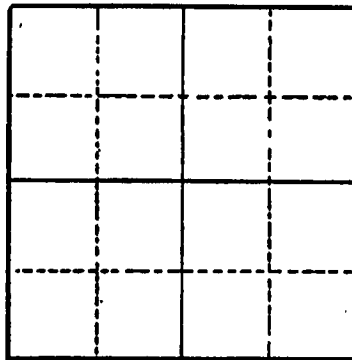

Section

Altitude at well 135

TYPE OF WELL: Drilled.. Date Constructed 1939

Depth drilled 60 Depth cased

CASING RECORD:

6 inch

FINISH:

AQUIFERS:

WATER LEVEL:

PUMPING EQUIPMENT: Type Jet H.P. 1
Capacity G.P.M.

WELL TESTS:

Drawdown ft. after hours G.P.M.

Drawdown ft. after hours G.P.M.

USE OF WATER Domestic, Irrigation Temp. °F. 19

SOURCE OF INFORMATION USGS

DRILLER or DIGGER

ADDITIONAL DATA:

Log Water Level Measurements Chemical Analysis Aquifer Test

REMARKS: