

STATE ENGINEER
Salem, Oregon

Well Record

STATE WELL NO. 7/3W-11B(1)
COUNTY Marion
APPLICATION NO. GR-211

~~MARI~~
MARI.....

16920
MARI

OWNER: Sylvia Brown Allen MAILING ADDRESS: _____

LOCATION OF WELL: Owner's No. #1 CITY AND STATE: Salem, Oregon


NW 1/4 NE 1/4 Sec. 11 T. 7 S., R. 3 W., W.M.

Bearing and distance from section or subdivision
corner 1100 feet south and 1800 feet west
from the NE corner, Section 11

Altitude at well 130 feet interpolated

TYPE OF WELL: Drilled Date Constructed 9-25-54

Depth drilled 45 Depth cased 45

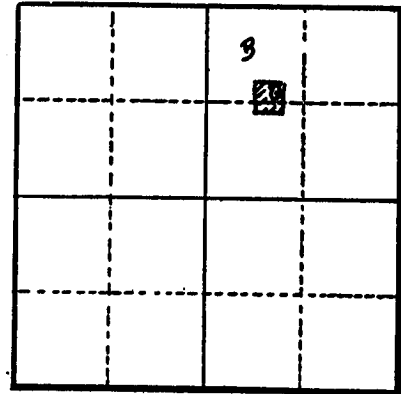

Section 11

CASING RECORD:

6-inch steel casing set from 0 to 45 feet

FINISH:

AQUIFERS:

WATER LEVEL:

19 feet below land surface October 1954

PUMPING EQUIPMENT: Type Homart Jet (Deep Well) H.P. 1
Capacity 23 G.P.M.

WELL TESTS:

Drawdown _____ ft. after _____ hours _____ G.P.M.

Drawdown _____ ft. after _____ hours _____ G.P.M.

USE OF WATER Irrigation 2 Temp. _____ °F. _____, 19

SOURCE OF INFORMATION GR0196

DRILLER or DIGGER Art Clinton

ADDITIONAL DATA:

Log no Water Level Measurements _____ Chemical Analysis _____ Aquifer Test _____

REMARKS: