

STATE ENGINEER
Salem, Oregon

Well Record

STATE WELL NO. 7/ 3W - 11H
COUNTY: MARION
APPLICATION NO. GR-2028

MAR 1952
16936
MAR

OWNER: Charles H. Kramer


MAILING ADDRESS: 1255 Candlewood Dr.

LOCATION OF WELL: Owner's No.

CITY AND STATE: Salem, Oregon

SE 1/4 NE 1/4 Sec. 11 T. 7 N. S., R. 3 W., W.M.

Bearing and distance from section or subdivision corner 2310' S. & 1800' W.

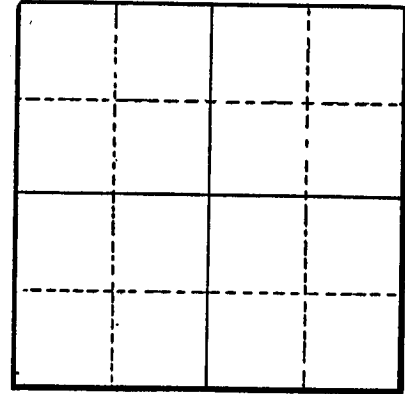

Section

Altitude at well

TYPE OF WELL: Driven Date Constructed 1952

Depth drilled 26 Depth cased 26

CASING RECORD:

2-inch

FINISH:

AQUIFERS:

WATER LEVEL:

12-feet

PUMPING EQUIPMENT: Type Jacuzzi Centrifugal H.P. 1
Capacity 36 G.P.M.

WELL TESTS:

Drawdown ft. after hours G.P.M.

Drawdown ft. after hours G.P.M.

USE OF WATER Irrigation Temp. °F., 19

SOURCE OF INFORMATION GR-1954

DRILLER or DIGGER Self

ADDITIONAL DATA:

Log Water Level Measurements Chemical Analysis Aquifer Test

REMARKS: