

STATE ENGINEER
Salem, Oregon

Well Record

STATE WELL NO. 7/3W-11L(1)
COUNTY Marion
APPLICATION NO. GR-152

OWNER: Harvey Machine Co., Inc.


MAILING ADDRESS: 3030 North Cherry Street

LOCATION OF WELL: Owner's No. 1

CITY AND STATE: Salem, Oregon

NE 1/4 SW 1/4 Sec. 11 T. 7 S., R. 3 W., W.M.

Bearing and distance from section or subdivision
corner 440 feet South 20° 30' West from NE
corner of SW 1/4

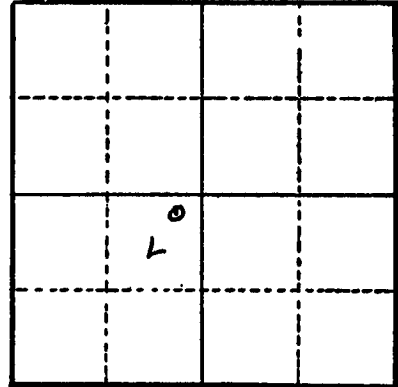

Section 11

Altitude at well 144 feet interpolated

TYPE OF WELL: Drilled Date Constructed June 1947

Depth drilled 76 Depth cased 76

CASING RECORD:

18-inch steel casing set from 0 to 76 feet

FINISH:

none

AQUIFERS:

sand and gravel 0 to 75 feet

WATER LEVEL:

12 to 18 feet below land surface June 1947

PUMPING EQUIPMENT: Type Sterling Deep well Turbine H.P. 50
Capacity 750 G.P.M.

WELL TESTS:

Drawdown 7 ft. after hours pumping 750 G.P.M.
Drawdown ft. after hours G.P.M.

USE OF WATER Industrial 2 cfs Temp. °F., 19

SOURCE OF INFORMATION GR-145

DRILLER or DIGGER

ADDITIONAL DATA:

Log x Water Level Measurements Chemical Analysis Aquifer Test

REMARKS:

sand and gravel 0 to 75
Clay, blue 75