

STATE ENGINEER
Salem, Oregon

Well Record

STATE WELL NO. 7/3W-12B
COUNTY MARION
APPLICATION NO. GR-2958

MAR 1927
16961
MAR 21

OWNER: Oscar D. Olson


MAILING ADDRESS: 4285 Portland Rd.

LOCATION OF WELL: Owner's No. _____

CITY AND STATE: Oregon

NW $\frac{1}{4}$ NE $\frac{1}{4}$ Sec. 12 T. 7 S., R. 3 W., W.M.

Bearing and distance from section or subdivision corner 1250' S & 310' E from N $\frac{1}{4}$ corner Sect 12

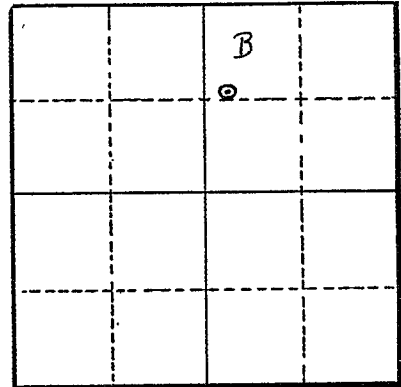

Section 12

Altitude at well _____

TYPE OF WELL: Drilled Date Constructed 1927

Depth drilled 68' Depth cased 68'

CASING RECORD:

6-inch

FINISH:

AQUIFERS:

WATER LEVEL: 30'

PUMPING EQUIPMENT: Type Jaccuzi Turbine H.P. 3
Capacity 60 G.P.M.

WELL TESTS:
Drawdown _____ ft. after _____ hours _____ G.P.M.
Drawdown _____ ft. after _____ hours _____ G.P.M.

USE OF WATER watering & gardening Temp. _____ °F. _____, 19____

SOURCE OF INFORMATION GR-3896

DRILLER or DIGGER _____

ADDITIONAL DATA:

Log NA Water Level Measurements _____ Chemical Analysis _____ Aquifer Test _____

REMARKS: