

STATE ENGINEER
Salem, Oregon

Well Record

STATE WELL NO. 7/3W-13R(1)
COUNTY Marion
APPLICATION NO. GR-262

OWNER: Edward J. Fischer
(Peonie Gardens)

MAILING ADDRESS: 2390 Alameda Street

LOCATION OF WELL: Owner's No. #1

CITY AND STATE: Salem, Oregon

SE $\frac{1}{4}$ SE $\frac{1}{4}$ Sec. 13 T. 7 N. S. R. 3 E. W. M.


Bearing and distance from section or subdivision

corner 780 feet West and 800 feet North from the
SE corner, Section 13, Lot 8, Block 6, Peony Gardens,
Salem, Oregon

Altitude at well 185 feet interpolated

TYPE OF WELL: Drilled Date Constructed Feb. 1955

Depth drilled 109 Depth cased 109

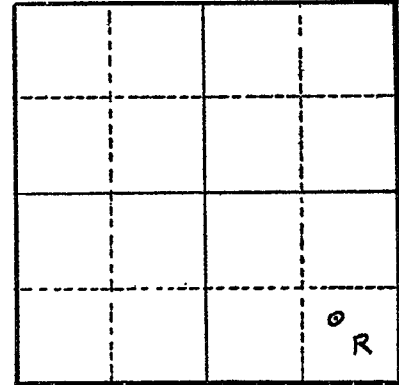

Section 13

CASING RECORD:

8-inch casing set from 0 to 109 feet

FINISH:

360 perforations $\frac{1}{4}$ x 8 set between 80 and 107 feet

AQUIFERS:

gravels from 42 to 109 feet

WATER LEVEL:

38 feet below land surface

PUMPING EQUIPMENT: Type Turbine H.P. 10
Capacity 140 G.P.M.

WELL TESTS:
Drawdown 90 ft. after _____ hours pumping 140 G.P.M.
Drawdown _____ ft. after _____ hours _____ G.P.M.

USE OF WATER Municipal use 140 gpm Temp. _____ °F. _____, 19____

SOURCE OF INFORMATION GR-243

DRILLER or DIGGER Sneed Bros. Drilling Co.

ADDITIONAL DATA:
Log _____ Water Level Measurements _____ Chemical Analysis _____ Aquifer Test _____

REMARKS:

Top soil	0	3	3	(yellow)			
Silt, yellow	3	32	29	Gravel, cemented & clay	54.5	66	11.5
Silt, blue	32	42	10	Gravel, " " blue	66	100.5	34.5
Gravel, cemented	42	53	11	Gravel, water bearing	100.5	101	1.5
Gravel, sulphur water	53	54.5	1.5	Gravel, cemented	101	109	8
				some water zones			