

STATE ENGINEER
Salem, Oregon

M 171 17031

Well Record

STATE WELL NO. 7/3W-14B
COUNTY Marion
APPLICATION NO. GR-4211

OWNER: Salem Nut Growers, Inc.
Glenn W. Hansberry, Sec-Mang.


MAILING ADDRESS: 2828 Cherry Avenue

LOCATION OF WELL: Owner's No.

CITY AND STATE: Salem, Oregon

NW 1/4 NE 1/4 Sec. 14 T. 7 N. S. R. 3 E. W., W.M.

Bearing and distance from section or subdivision corner
1120 feet South and 700 feet East
from the NW Corner of the NE 1/4

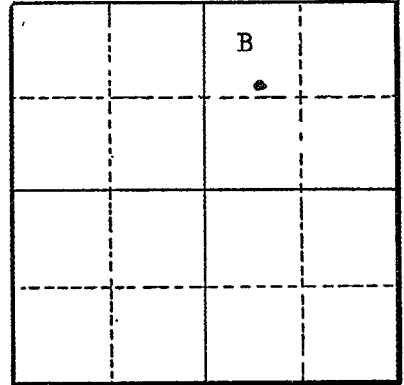

Altitude at well 70 feet

TYPE OF WELL: Drilled Date Constructed 1947

Depth drilled 92 feet Depth cased 92 feet

Section 14

CASING RECORD:

12-inch casing set from ground to 92 feet (steel)

FINISH:

AQUIFERS:

WATER LEVEL:
30 feet

PUMPING EQUIPMENT: Type Pearless H.P.
Capacity 200 G.P.M.

WELL TESTS:
Drawdown 10 ft. after 350 hours G.P.M.
Drawdown ft. after hours G.P.M.

USE OF WATER Industrial and Manufacturing Temp. °F., 19

SOURCE OF INFORMATION GR-4070

DRILLER or DIGGER Fred Wymore and Son

ADDITIONAL DATA:
Log (NA) Water Level Measurements Chemical Analysis Aquifer Test

REMARKS: