

STATE ENGINEER
Salem, Oregon

Well Record

STATE WELL NO. 7/3W-14F
COUNTY Marion
APPLICATION NO. GR-1481

~~17032~~
MAY 17 1932


GR- 1431

OWNER: M. B. Clatterbuck, Supt. of Oregon MAILING ADDRESS: _____

LOCATION OF WELL: School for the deaf. CITY AND STATE: Salem, Oregon
Owner's No. #1

SE 1/4 NW 1/4 Sec. 14 T. 7 S., R. 3 W., W.M.

Bearing and distance from section or subdivision
corner 3200' W. & 1570' S. from NE cor. Sec. 14

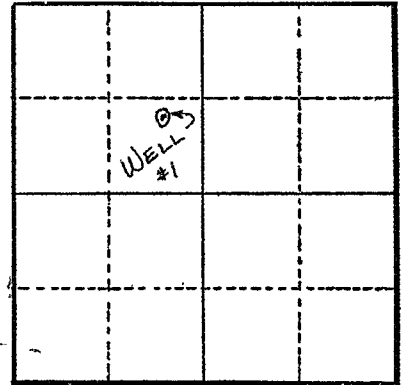

Section 14

Altitude at well 152'

TYPE OF WELL: Drilled Date Constructed 1920

Depth drilled 60' Depth cased 60'

CASING RECORD:
8"

FINISH:

AQUIFERS:

WATER LEVEL:
20'

PUMPING EQUIPMENT: Type 4" turbine Sterling H.P. 7 1/2
Capacity 250 G.P.M.

WELL TESTS:
Drawdown _____ ft. after _____ hours _____ G.P.M.
Drawdown _____ ft. after _____ hours _____ G.P.M.

USE OF WATER Dom. & irrigation Temp. _____ °F., 19

SOURCE OF INFORMATION GR Record

DRILLER or DIGGER _____

ADDITIONAL DATA:

Log N.A. Water Level Measurements _____ Chemical Analysis _____ Aquifer Test _____

REMARKS:

Irrigation of 50 acres