


STATE ENGINEER
Salem, Oregon

~~Well~~ **Well Record**
MAR. 19033 GR-1432

STATE WELL NO. 7/3W-14E
COUNTY Marion
APPLICATION NO. GR-1482

OWNER: M.B. Clatterbuck, Supt. Oregon
School for the deaf.
LOCATION OF WELL: Owner's No. #2
MAILING ADDRESS: _____
CITY AND STATE: Salem, Oregon

SE 1/4 NW 1/4 Sec. 14 T. 7 S., R. 3 W., W.M.
Bearing and distance from section or subdivision
corner 3340' W. & 1350' S. from NE cor. Sec. 14

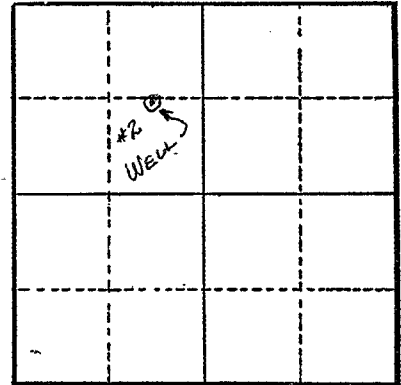

Section 14

Altitude at well 152'

TYPE OF WELL: Drilled Date Constructed 1950
Depth drilled 153' Depth cased 153'

CASING RECORD:
10"

FINISH:
Perforated casing every 3' to bottom of well.

AQUIFERS:

WATER LEVEL:
20'

PUMPING EQUIPMENT: Type 5" turbine H.P. 30
Capacity 400 G.P.M.

WELL TESTS:
Drawdown _____ ft. after _____ hours _____ G.P.M.
Drawdown _____ ft. after _____ hours _____ G.P.M.

USE OF WATER Dom. & Irrigation Temp. _____ °F., 19

SOURCE OF INFORMATION GR Record
DRILLER or DIGGER R. Stadeli & Sons

ADDITIONAL DATA:
Log Water Level Measurements _____ Chemical Analysis _____ Aquifer Test _____

REMARKS:
Irrigation of 50 acres.

