

STATE ENGINEER
Salem, Oregon

1708
MAR 1946

Well Record


STATE WELL NO. 5/1W-9B
COUNTY Marion
APPLICATION NO. GR-4213

OWNER: MacLaren School for Boys, State of MAILING ADDRESS: _____

LOCATION OF WELL: Owner's No. _____ CITY AND STATE: Woodburn, Oregon

NW ¼ NE ¼ Sec. 9 T. 5 N. S., R. 1 E. W., W.M.

Bearing and distance from section or subdivision corner 2850' W and 800' N from the NE corner of the C. Cooley DLC 41

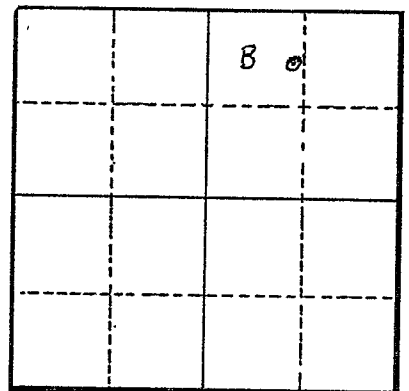

Altitude at well _____

TYPE OF WELL: Drilled Date Constructed 1946

Depth drilled NA Depth cased _____

CASING RECORD:

12-inch

FINISH:

AQUIFERS:

WATER LEVEL:

30'

PUMPING EQUIPMENT: Type Deming Turbine H.P. 40
Capacity 400 G.P.M.

WELL TESTS:
Drawdown _____ ft. after _____ hours _____ G.P.M.
Drawdown _____ ft. after _____ hours _____ G.P.M.

USE OF WATER Irrigation Temp. _____ °F. _____, 19____

SOURCE OF INFORMATION GR-3838

DRILLER or DIGGER NA

ADDITIONAL DATA:
Log NA Water Level Measurements _____ Chemical Analysis _____ Aquifer Test _____

REMARKS: