

STATE ENGINEER
Salem, Oregon



Well Record

STATE WELL NO. 5/1W-9C
COUNTY Marion
APPLICATION NO. GR-4212

OWNER: State of Oregon MacLaren School
for Boys

MAILING ADDRESS:
CITY AND STATE:


Woodburn, Oregon

LOCATION OF WELL: Owner's No.

NE 1/4 NW 1/4 Sec. 9 T. 5 N. S. R. 1 E. W.M.

Bearing and distance from section or subdivision
corner 4200' W & 250' N from NE corner

C, Cooley DLC 41

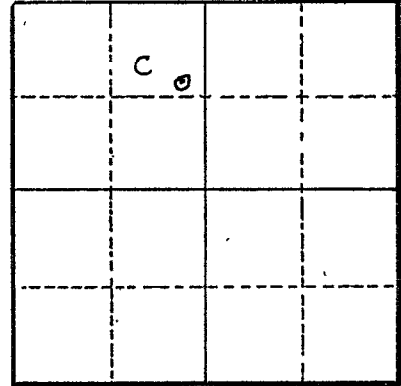

Section 9

Altitude at well

TYPE OF WELL: Drilled Date Constructed 1926

Depth drilled 230' Depth cased 230'

CASING RECORD:

12-inch
10-inch

FINISH:

AQUIFERS:

WATER LEVEL:

30'

PUMPING EQUIPMENT: Type Jacuzzi Turbine

H.P. 60

Capacity 650 G.P.M.

WELL TESTS:

Drawdown 25 ft. after hours 350 G.P.M.

Drawdown 65 ft. after hours 675 G.P.M.

USE OF WATER Domestic & Irrigation Temp. °F., 19

SOURCE OF INFORMATION GR-3837

DRILLER or DIGGER NA

ADDITIONAL DATA:

Log NA Water Level Measurements Chemical Analysis Aquifer Test

REMARKS: