

STATE ENGINEER
Salem, Oregon

MAR 17 1946

Well Record


STATE WELL NO. 5/1W-9F(1)
COUNTY Marion
APPLICATION NO. GR-25

OWNER: R. A. Lohse
MAILING ADDRESS: Route 1, Box 88

LOCATION OF WELL: Owner's No. 1
CITY AND STATE: Woodburn, Oregon

SE 1/4 NW 1/4 Sec. 9 T. 5 N. S., R. 1 E., W.M.

Bearing and distance from section or subdivision
corner 141 feet north of center of Molalla
Road and 281 feet northeast of the SW
corner of Lot 9 Woodburn Fruit Farms

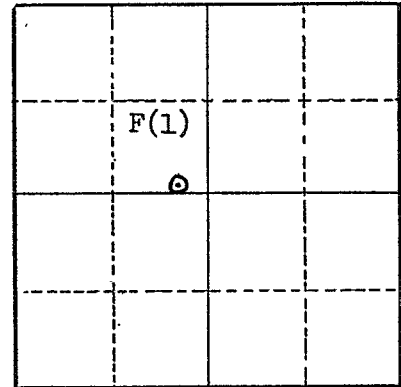

Section 9

Altitude at well 250 feet Interpolated

TYPE OF WELL: Drilled Date Constructed July '46

Depth drilled 120 Depth cased 120

CASING RECORD:

6 inch casing set from 0 to 120 feet

FINISH:

None

AQUIFERS:

Sands, from 20 to 120 feet

WATER LEVEL:

20 feet below land surface

PUMPING EQUIPMENT: Type Jacuzzi turbine H.P. 5
Capacity 60 G.P.M.

WELL TESTS:

Drawdown 20 ft. after hours 131 G.P.M.

Drawdown ft. after hours G.P.M.

USE OF WATER Irrigation 13 acres Temp. °F., 19

SOURCE OF INFORMATION Registration Statement GR-25

DRILLER or DIGGER Peter Hornig Canby, Oregon

ADDITIONAL DATA:

Log Water Level Measurements Chemical Analysis Aquifer Test

REMARKS:

