

STATE ENGINEER
Salem, Oregon

MAR 17 1945

Well Record

STATE WELL NO. 5/1W-9J(1)
COUNTY Marion
APPLICATION NO. GR-1043

GR- 1005

OWNER: Albert E. Morris


MAILING ADDRESS: 2760 Molalla Rd.

LOCATION OF WELL: Owner's No. #1

CITY AND STATE: Woodburn, Oregon

NE 1/4 SE 1/4 Sec. 9 T. 5 S., R. 1 W., W.M.

Bearing and distance from section or subdivision corner 2500' N. & 700' W. from SE. cor. Sec. 9.

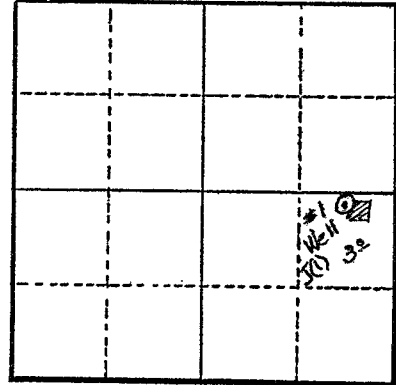

Section 9

Altitude at well 170

TYPE OF WELL: Drilled Date Constructed 1945

Depth drilled 100 ft. Depth cased 100 ft.

CASING RECORD:

6 inch

FINISH:

AQUIFERS:

Gravel

WATER LEVEL:

35 ft.

PUMPING EQUIPMENT: Type Myers Jet

H.P. 1

Capacity 40 G.P.M.

WELL TESTS:

Drawdown 45 ft. after 30 hours G.P.M.

Drawdown _____ ft. after _____ hours G.P.M.

USE OF WATER Irrigation Temp. _____ °F., 19

SOURCE OF INFORMATION G.R. Record

DRILLER or DIGGER Horning, Canby, Oregon

ADDITIONAL DATA:

Log _____ Water Level Measurements _____ Chemical Analysis _____ Aquifer Test _____

REMARKS:

Log: Clay, yellow 0
Clay, blue to
Gravels 30 ft.

Irrigation of 3 acres.