

STATE ENGINEER
Salem, Oregon

Well Record

STATE WELL NO. 5/1W-9M(1)
COUNTY Marion
APPLICATION NO. GR. 1069

GR= 1031

OWNER: John A & Marie Erickson


MAILING ADDRESS:

LOCATION OF WELL: Owner's No.

CITY AND STATE: Woodburn, Oregon

NW 1/4 SW 1/4 Sec. 9 T. 5 S., R. 1 W., W.M.

Bearing and distance from section or subdivision corner 20.5 ch. W. & 2.3 ch. S. from Center of Section 9.

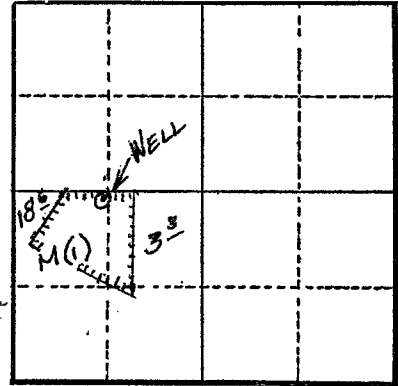

Section 9

Altitude at well

TYPE OF WELL: Drilled Date Constructed 1953

Depth drilled 122 ft. Depth cased

CASING RECORD:

8 inch

FINISH:

Perforated - 7 rows of 8 cuts to the row from 115 to 121 ft.

AQUIFERS:

WATER LEVEL:

31 ft.

PUMPING EQUIPMENT: Type Jacuzzi turbine

H.P. 5

Capacity 150 G.P.M.

WELL TESTS:

Drawdown 54 ft. after 100 hours G.P.M.

Drawdown 95 ft. after 250 hours G.P.M.

USE OF WATER Irrigation Temp. °F. 19

SOURCE OF INFORMATION G.R. Record

DRILLER or DIGGER

ADDITIONAL DATA:

Log Water Level Measurements Chemical Analysis Aquifer Test

REMARKS:

Log: Top soil & silty subsoil	0 to 37 ft.
Blue shale	37 to 77 ft.
Sand & shale	77 to 98 ft.
Sand & gravel	98 to 108 ft.
Sand, black	108 to 114 ft.
Sand & gravel (water)	114 to 122 ft.
Shale & gravel(hard)	122 to ???

Irrigation of 21.9 acres.