

STATE ENGINEER
Salem, Oregon

Well Record

STATE WELL NO. 5/1W-9M(2)
COUNTY Marion
APPLICATION NO. GR-1070

MAR 17 1951

GR- 1032

OWNER: Abraham Siemens


MAILING ADDRESS: 34 SE 71st

LOCATION OF WELL: Owner's No. _____

CITY AND STATE: Portland 16, Oregon

NW 1/4 SW 1/4 Sec. 9 T. 5 S., R. 1 W., W.M.

Bearing and distance from section or subdivision
corner 750' E. & 175' N. from SW cor. of the
NW 1/4 of Section 9.

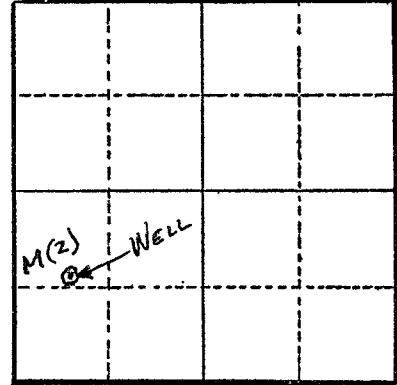

Section 9

Altitude at well _____

TYPE OF WELL: Drilled Date Constructed 1951

Depth drilled 117 ft. Depth cased 117 ft.

CASING RECORD:

8 inch

FINISH:

AQUIFERS:

WATER LEVEL:

31 ft.

PUMPING EQUIPMENT: Type Peerless turbine H.P. 5
Capacity 100 G.P.M.

WELL TESTS:

Drawdown 23 ft. after _____ hours 100 G.P.M.
Drawdown 64 ft. after _____ hours 250 G.P.M.

USE OF WATER Irrigation Temp. _____ °F., 19____

SOURCE OF INFORMATION G.R. Record

DRILLER or DIGGER Coleman

ADDITIONAL DATA:

Log _____ Water Level Measurements _____ Chemical Analysis _____ Aquifer Test _____

REMARKS:

Log: Top soil 0 to 2 ft.
Brown clay 2 to 16 ft.
Silt 16 to 19 ft.
Blue clay 19 to 100 ft.
Water bearing black sand 100 to 111 ft.
Water bearing gravel 111 to 117 ft.

Irrigation of 15 acres.