

STATE ENGINEER
Salem, Oregon

1718
MARION

Well Record

STATE WELL NO. 5/1W-9M(3)
COUNTY Marion
APPLICATION NO. GR-1081

GR- 1043

OWNER: Carl L. Erickson


MAILING ADDRESS: 2230 Meadow Lane

LOCATION OF WELL: Owner's No.

CITY AND STATE: Woodburn, Oregon

NW 1/4 SW 1/4 Sec. 9 T. 5 S., R. 1 W., W.M.

Bearing and distance from section or subdivision corner 1700' N. & 210' E. from SW cor. Sec. 9.

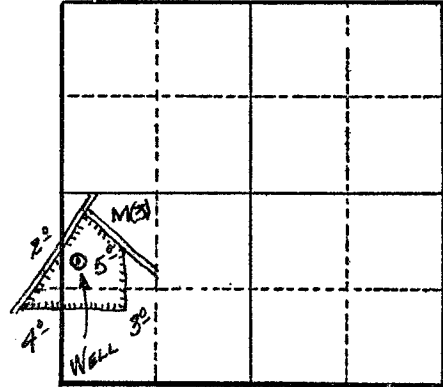

Section 9

Altitude at well 178 ft.

TYPE OF WELL: Drilled Date Constructed 1953

Depth drilled 119 ft. Depth cased 119 ft.

CASING RECORD:

8 inch.

FINISH:

Perforated with Mills perforator with 13 rows of 8 cuts per from 111 to 118 ft.

AQUIFERS:

WATER LEVEL:

25 ft.

PUMPING EQUIPMENT: Type Jacuzzi turbine H.P. 5
Capacity 150 G.P.M.

WELL TESTS:

Drawdown 68 ft. after 400 hours G.P.M.
Drawdown 43 ft. after 100 hours G.P.M.

USE OF WATER Irrigation Temp. °F. 19

SOURCE OF INFORMATION G.R. Record

DRILLER or DIGGER Perkins

ADDITIONAL DATA:

Log Water Level Measurements Chemical Analysis Aquifer Test

REMARKS:

Log: Top soil & silty soil 0 to 45 ft.
Blue shale 45 to 77 ft.
Black sand 77 to 92 ft.
Black sand & shale 92 to 96 ft.
Black blow sand 96 to 101 ft.
Water bearing sand & gravel 101 to 106 ft. (106' to 119' left out)
Gravel & shale (tight) 119 to ???

Irrigation of 14 acres.