

STATE ENGINEER  
Salem, Oregon

1720  
MART...

# Well Record


STATE WELL NO. 5/1W-9P(1)  
COUNTY Marion  
APPLICATION NO. GR-724

OWNER: Ivan Lazaroff  
MAILING ADDRESS: 2730 Meadow Lane

LOCATION OF WELL: Owner's No. #1  
CITY AND STATE: Woodburn, Oregon

SE<sup>1</sup>/<sub>4</sub> SW<sup>1</sup>/<sub>4</sub> Sec. 9 T. 5 N. S., R. 1 E. W.M.

Bearing and distance from section or subdivision  
corner 1500' E. & 1200' N, from SW cor. Sec. 9

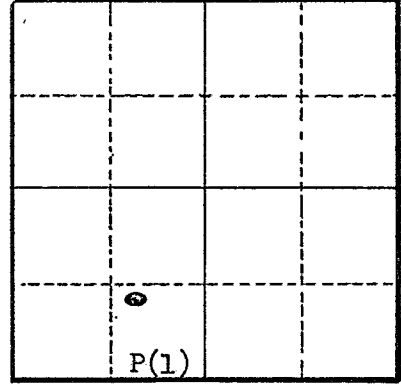

Altitude at well

TYPE OF WELL: Drilled Date Constructed 1955

Depth drilled 110 Depth cased 110

Section 9

### CASING RECORD:

5 inch from 0 to 110 feet

### FINISH:

### AQUIFERS:

### WATER LEVEL:

PUMPING EQUIPMENT: Type Turbine H.P. 5  
Capacity 40 G.P.M.

### WELL TESTS:

Drawdown 20 ft. after hours 40 G.P.M.  
Drawdown ft. after hours G.P.M.

USE OF WATER Irrigation Temp. °F. 19

SOURCE OF INFORMATION GR-724

DRILLER or DIGGER

### ADDITIONAL DATA:

Log None Water Level Measurements Chemical Analysis Aquifer Test

### REMARKS: