

STATE ENGINEER
Salem, Oregon

Well Record

STATE WELL NO. 5/1W-10J(1)
COUNTY Marion
APPLICATION NO. GR-57

OWNER: Raymond C. McNulty

MAILING
ADDRESS:

LOCATION OF WELL: Owner's No.


CITY AND
STATE:

Woodburn, Oregon

NE 1/4 SE 1/4 Sec. 10 T. 5 S. R. 1 W., W.M.

Bearing and distance from section or subdivision

corner 5.32 chains south of NE cor. of the SE 1/4
of Section 10

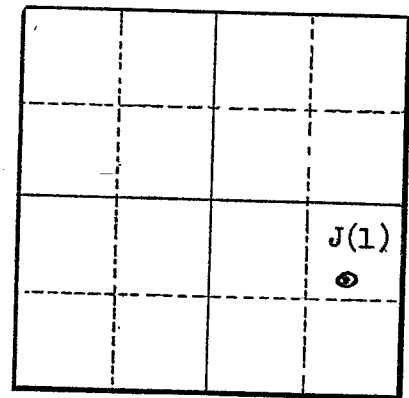

Altitude at well 150 feet Interpolated

TYPE OF WELL: Drilled Date Constructed June 1945

Depth drilled 53 Depth cased 48

Section 10

CASING RECORD:

6 inch casing set from 0 to 48 feet

FINISH:

None

AQUIFERS:

Sand

WATER LEVEL:

10 feet below land surface April 1955

PUMPING EQUIPMENT: Type Jacuzzi Turbine H.P. 5
Capacity 75 G.P.M.

WELL TESTS:

Drawdown 40 ft. after 75 hours G.P.M.

Drawdown ft. after hours G.P.M.

USE OF WATER Domestic & irrigation 29 a Temp. °F. 19

SOURCE OF INFORMATION Registration Statement GR-57

DRILLER or DIGGER James Ballweber Woodburn, Oregon Rt. 2

ADDITIONAL DATA:

Log No Water Level Measurements Chemical Analysis Aquifer Test

REMARKS: