

STATE ENGINEER  
Salem, Oregon

MARI 7758

# Well Record

STATE WELL NO. 5/1W-15B(1)  
COUNTY Marion  
APPLICATION NO. GR-771

*Drilled Deeper*

OWNER: Butsch Brothers


MAILING ADDRESS: Route 1, Box 99

LOCATION OF WELL: Owner's No. 1

CITY AND STATE: Mt. Angel, Oregon

NW ¼ NE ¼ Sec. 15 T. 5 S., R. 1 W., W.M.

Bearing and distance from section or subdivision corner 2350' W. & 250' from NE cor. of Sec. 15

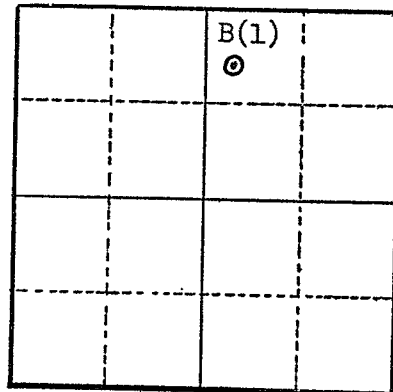

Section 15

Altitude at well 150' Interpolated

TYPE OF WELL: Drilled Date Constructed Sept. 1, 51

Depth drilled 145' Depth cased 145'

### CASING RECORD:

10 inch

### FINISH:

8 rows perforations 3/8" x 1 1/2" slots 77 to 90 feet  
5 per foot 123 to 145 feet

### AQUIFERS:

### WATER LEVEL:

24 feet

PUMPING EQUIPMENT: Type Cook turbine pump H.P. 30  
Capacity 430 G.P.M.

### WELL TESTS:

Drawdown 74 ft. after 360 hours G.P.M.

Drawdown 104 ft. after 430 hours G.P.M.

USE OF WATER Irrigation Temp. 19 °F.

SOURCE OF INFORMATION GR-771

DRILLER or DIGGER

### ADDITIONAL DATA:

Log Yes Water Level Measurements Chemical Analysis Aquifer Test

### REMARKS:

