

STATE ENGINEER  
Salem, Oregon

1759  
MART...

# Well Record

STATE WELL NO. 5/1W-15K(1)  
COUNTY Marion  
APPLICATION NO. GR-2

OWNER: W. Earl Dunn

MAILING ADDRESS:


LOCATION OF WELL: Owner's No. 1

CITY AND STATE:

Woodburn, Oregon

NW 1/4 SE 1/4 Sec. 15 T. 5 N. S., R. 1 E. W.M.

Bearing and distance from section or subdivision corner 700' S. & 420' E. from center of Sec. 15.

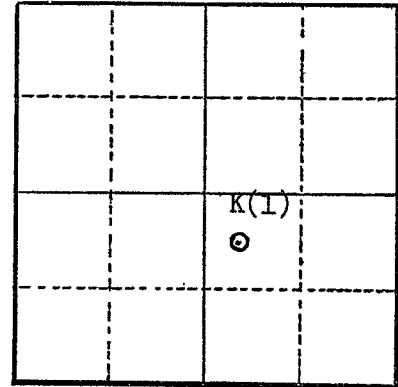

Section 15

Altitude at well 150' Interpolated

TYPE OF WELL: Drilled Date Constructed 6-10-51

Depth drilled 91' Depth cased 91'

### CASING RECORD:

10 inch casing set from 0 to 91 feet

### FINISH:

Slot perforations from 75 to 90 feet

### AQUIFERS:

### WATER LEVEL:

1 foot below land surface June 23, 1951

PUMPING EQUIPMENT: Type Pacific Pump 3 phase H.P. 7 1/2  
Capacity 175 G.P.M.

### WELL TESTS:

Drawdown	65	ft. after	hours	450	G.P.M.
Drawdown	41	ft. after	hours	290	G.P.M.
Drawdown	31	ft. after	hours	200	G.P.M.

USE OF WATER Irrigation 31 acres Temp. °F. 19

SOURCE OF INFORMATION Registration Statement GR-2

DRILLER or DIGGER Fred Wymore Rt. 2, Salem, Oregon

### ADDITIONAL DATA:

Log No Water Level Measurements Chemical Analysis Aquifer Test

### REMARKS: