

STATE ENGINEER  
Salem, Oregon




# MARI 1816 Well Record

STATE WELL NO. 5/W-17B  
COUNTY Marion  
APPLICATION NO. GR-3614

OWNER: Ursel Livingston MAILING ADDRESS: 1690 E. Lincoln Rd.

LOCATION OF WELL: Owner's No. \_\_\_\_\_ CITY AND STATE: Woodburn, Oregon

NW 1/4 NE 1/4 Sec. 17 T. 5 S., R. 1 W., W.M.  
Bearing and distance from section or subdivision  
corner 4 ch. N. & 8.5 ch. W. SE cor. NW 1/4  
Sec. 17

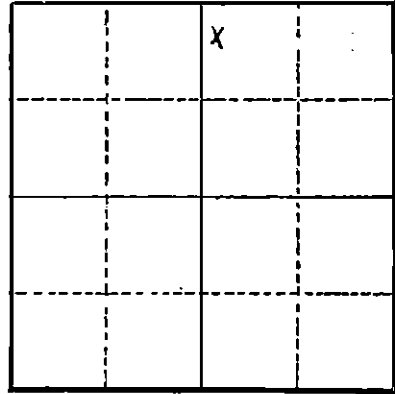

Section 17

Altitude at well \_\_\_\_\_

TYPE OF WELL: Drilled Date Constructed 1/15/54

Depth drilled 125 ft. Depth cased 125 ft.

### CASING RECORD:

8 inch casing set to 125 feet

### FINISH:

### AQUIFERS:

### WATER LEVEL:

16 feet below surface

PUMPING EQUIPMENT: Type Peerless turbine H.P. 5  
Capacity 100 G.P.M.

### WELL TESTS:

Drawdown 70 ft. after \_\_\_\_\_ hours 250 G.P.M.

Drawdown \_\_\_\_\_ ft. after \_\_\_\_\_ hours \_\_\_\_\_ G.P.M.

USE OF WATER Irrigation Temp. \_\_\_\_\_ °F., 19.

SOURCE OF INFORMATION Well Registration Statement

DRILLER or DIGGER J. W. Beck

### ADDITIONAL DATA:

Log X Water Level Measurements \_\_\_\_\_ Chemical Analysis \_\_\_\_\_ Aquifer Test \_\_\_\_\_

### REMARKS:

Log:	Thickness	Depth to Bottom
Brown silt	0	
Blue silt		
Land		
Blue clay		
Blue sand & gravel		
Brown gravel very little sand		125

STATE ENGINEER  
Salem, Oregon

MARI 1816

# MARI 1816 Well Record

STATE WELL NO. 5/1W-17B(1)  
COUNTY Marion  
APPLICATION NO. GR 3614

OWNER: Orsel Livingston


MAILING ADDRESS:

LOCATION OF WELL: Owner's No.

CITY AND STATE:

..... 1/4 ..... 1/4 Sec. .... T. .... N. .... E.  
..... S., R. .... W., W.M.

Bearing and distance from section or subdivision corner

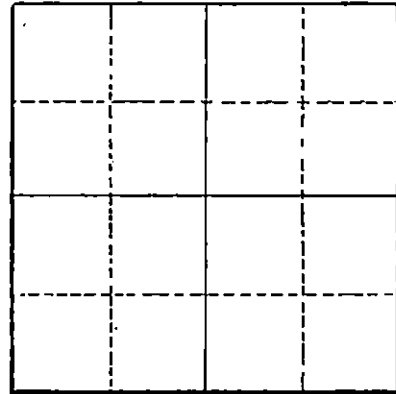

Section .....

Altitude at well ..... 171

TYPE OF WELL: Drilled Date Constructed 1954

Depth drilled ..... 125 ..... Depth cased ..... 125

CASING RECORD:  
8 inch

FINISH:

Casing perforated 110 to 125

AQUIFERS:

Brown gravel from 110 to 125

WATER LEVEL:

16 feet below land surface on February 1, 1954

PUMPING EQUIPMENT: Type Turbine H.P. 5  
Capacity ..... G.P.M.

WELL TESTS:

Drawdown ..... ft. after ..... hours ..... G.P.M.

Drawdown ..... ft. after ..... hours ..... G.P.M.

USE OF WATER Irrigation Temp. °F. ...., 19

SOURCE OF INFORMATION USGS

DRILLER or DIGGER

ADDITIONAL DATA:

Log ..... Water Level Measurements ..... Chemical Analysis ..... Aquifer Test .....

REMARKS: