

STATE ENGINEER
Salem, Oregon

Well Record

STATE WELL NO. 5/1W-17D(1)
COUNTY Marion
APPLICATION NO. GR-209


1822
MARION

OWNER: Clyde A. McBae MAILING ADDRESS: _____

LOCATION OF WELL: Owner's No. _____ CITY AND STATE: Woodburn, Oregon

NW $\frac{1}{4}$ NW $\frac{1}{4}$ Sec. 17 T. 5 ^{N.}S., R. 1 ^{E.}W., W.M.

Bearing and distance from section or subdivision corner 2200' N. & 50' E. from W $\frac{1}{4}$ cor. Sec. 17

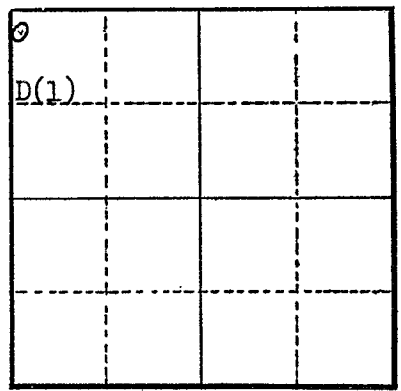

Section 17

Altitude at well 175' Interpolated

TYPE OF WELL: Dug Date Constructed 6/7/55

Depth drilled 7' Depth cased None

CASING RECORD:

48" hole, no casing 0 to 7 feet

FINISH:

none

AQUIFERS:

unknown

WATER LEVEL:

4 feet below land surface

PUMPING EQUIPMENT: Type Centrifugal H.P. $\frac{1}{4}$
Capacity 10 G.P.M.

WELL TESTS:

Drawdown _____ ft. after _____ hours _____ G.P.M.
Drawdown _____ ft. after _____ hours _____ G.P.M.

USE OF WATER Irrigation 1.5 acres Temp. _____ °F., 19____

SOURCE OF INFORMATION Registration Statement GR-209

DRILLER or DIGGER Owner

ADDITIONAL DATA:

Log No Water Level Measurements _____ Chemical Analysis _____ Aquifer Test _____

REMARKS:

Soil & clay 0 to 7 feet