

STATE ENGINEER
Salem, Oregon

1826
MARI.....


OBSERVATION WELL Well Record

STATE WELL NO. 5/1W - 17M(2)
APPLICATION NO. GR-2218

OWNER: General Foods Corporation, Birds Eye Division
MAILING ADDRESS: P. O. Box 89
LOCATION OF WELL: Owner's No. #2
CITY AND STATE: Hillsboro, Oregon

NW 1/4 SW 1/4 Sec. 17 T. 5 N. S., R. 1 E. W., W.M.

Bearing and distance from section or subdivision corner 1700' N. and 300' E.

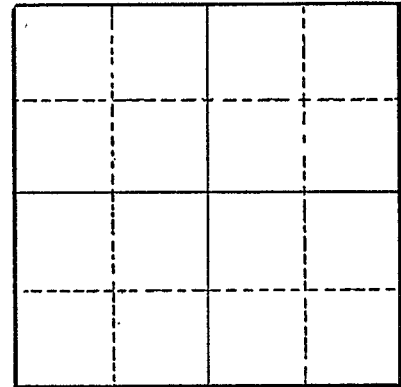

Section

Altitude at well

TYPE OF WELL: Drilled Date Constructed 1946

Depth drilled 200 Depth cased 170

CASING RECORD:

12-inch

FINISH:

Perforations from 123 to 135
Perforations from 142 to 154
Perforations from 160 to 170

AQUIFERS:

Gravel

WATER LEVEL:

23-Feet

PUMPING EQUIPMENT: Type Peerless Capacity 750 G.P.M. H.P. 60

WELL TESTS:

Drawdown 50 ft. after hours Pumping 1000 G.P.M.
Drawdown 40 ft. after hours Pumping 750 G.P.M.

USE OF WATER Food Processing Temp. °F. 19

SOURCE OF INFORMATION GR-2123
DRILLER or DIGGER R. J. Strasser Drilling Co., 8110 S. E. Sunset Lane, Portland 6, Oregon

ADDITIONAL DATA:

Log Water Level Measurements Chemical Analysis Aquifer Test

REMARKS:

