

STATE ENGINEER
Salem, Oregon

MARI. 1897
MARI.....

MAR 1947
Well Record

STATE WELL NO. 5/1W-18C
COUNTY Marion
APPLICATION NO. GR-2389
Old SP RR Well

OWNER: Warren Denner, City Water Supt
MAILING ADDRESS: City of Woodburn

LOCATION OF WELL: Owner's No. _____
CITY AND STATE: Woodburn, Oregon


NE 1/4 NW 1/4 Sec. 18 T. 5 N. S. R. 1 E. W., W.M.

Bearing and distance from section or subdivision corner

Altitude at well

TYPE OF WELL: Drilled Date Constructed 1913

Depth drilled 176 Depth cased

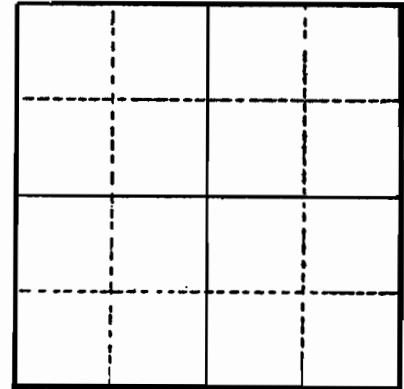

Section 18

CASING RECORD:

Not known

FINISH:

Not known

AQUIFERS:

Not known

WATER LEVEL:

60 feet

PUMPING EQUIPMENT: Type Byron Jackson deep water turbine H.P. 10
Capacity 160-180 G.P.M.

WELL TESTS:

Drawdown ft. after hours G.P.M.
Drawdown ft. after hours G.P.M.

USE OF WATER Municipal Water Supply Temp. °F., 19

SOURCE OF INFORMATION GR-2389

DRILLER or DIGGER

ADDITIONAL DATA:

Log Water Level Measurements Chemical Analysis Aquifer Test

REMARKS:

