

STATE ENGINEER
Salem, Oregon

OBSERVATION WELL
Well Record

STATE WELL NO. 5/1W-18Q(1)
COUNTY Marion
APPLICATION NO. GR-747

MARI. 1856

OWNER: Lawrence J. Paradis


MAILING ADDRESS: 515 S. Pac. Hwy.

LOCATION OF WELL: Owner's No. #1

CITY AND STATE: Woodburn, Oregon

SW 1/4 SE 1/4 Sec. 18 T. 5 N. S. R. 1 W. W.M.

Bearing and distance from section or subdivision corner 1720' W. & 900' N. from SE corner section 18.

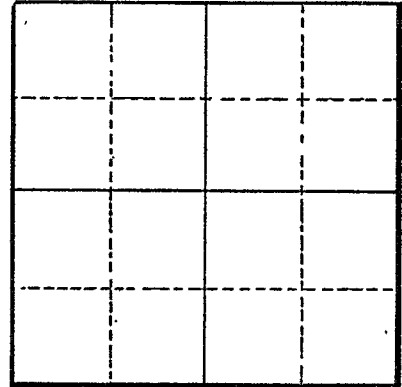

Section 18

Altitude at well 176 feet

TYPE OF WELL: Drilled Date Constructed 7/15/43

Depth drilled 126' 132' Depth cased

CASING RECORD:

10 inch

FINISH:

AQUIFERS:

WATER LEVEL:

16 feet 22 1/2 ? 1-30-60

PUMPING EQUIPMENT: Type Single phase- Peerless turbine type H.P. 7 1/2
Capacity G.P.M.

WELL TESTS:

Drawdown ft. after hours G.P.M.
Drawdown ft. after hours G.P.M.

USE OF WATER Irrigation - 46.6 49 ac. Temp. °F., 19

SOURCE OF INFORMATION GR-747

DRILLER or DIGGER Ray Perkins, Salem

ADDITIONAL DATA:

Log None Water Level Measurements Chemical Analysis Aquifer Test

REMARKS: