

STATE ENGINEER
Salem, Oregon

Well Record

STATE WELL NO. 5/1W-19B
COUNTY MARION
~~APPLICATION NO.~~ GR-2898

MARION
1890

OWNER: Charles Denskey


MAILING ADDRESS: 875 S. Pfe. Highway Pg 1 of 2

LOCATION OF WELL: Owner's No. _____

CITY AND STATE: Woodburn, Oregon

NW 1/4 NE 1/4 Sec. 19 T. 5 ^{N.} S., R. 1 ^{E.} W., W.M.

Bearing and distance from section or subdivision corner 350' E. 950' S. N1/4

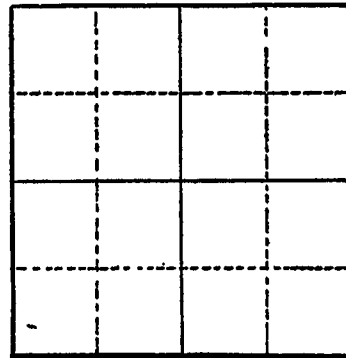

Altitude at well _____

TYPE OF WELL: Drilled Date Constructed 1948

Depth drilled 80 Depth cased 80

Section _____

CASING RECORD:

12-inch

FINISH:

AQUIFERS:

WATER LEVEL:
16-feet

PUMPING EQUIPMENT: Type Jacuzzi Jet H.P. 2
Capacity 20 G.P.M.

WELL TESTS:

Drawdown _____ ft. after _____ hours _____ G.P.M.

Drawdown _____ ft. after _____ hours _____ G.P.M.

USE OF WATER Irrigation Temp. _____ °F. _____, 19____

SOURCE OF INFORMATION GR-2727

DRILLER or DIGGER _____

ADDITIONAL DATA:

Log _____ Water Level Measurements _____ Chemical Analysis _____ Aquifer Test _____

REMARKS:

STATE ENGINEER
Salem, Oregon

Well Record

STATE WELL NO. 5/1W-19B(2)
COUNTY Marion
APPLICATION NO. _____

MARI...
189D

OWNER: Charles Dansky

MAILING ADDRESS: _____
CITY AND STATE: _____

Pg 2 of 2

LOCATION OF WELL: Owner's No. _____
N. E.
S. R. W., W.M.
_____ 1/4 _____ 1/4 Sec. _____ T. _____

Bearing and distance from section or subdivision corner _____

Altitude at well 182

TYPE OF WELL: Drilled Date Constructed 1948

Depth drilled 80 Depth cased _____

Section _____

CASING RECORD:

12 inch

FINISH:

AQUIFERS:

WATER LEVEL:

16 feet

PUMPING EQUIPMENT: Type Jet H.P. 2
Capacity _____ G.P.M.

WELL TESTS:

Drawdown _____ ft. after _____ hours _____ G.P.M.
Drawdown _____ ft. after _____ hours _____ G.P.M.

USE OF WATER Irrigation--13 acres Temp. _____ °F. _____, 19_____

SOURCE OF INFORMATION USGS

DRILLER or DIGGER _____

ADDITIONAL DATA:

Log _____ Water Level Measurements _____ Chemical Analysis _____ Aquifer Test _____

REMARKS:

Tile casing.