


MARI 185 **RECEIVED**

MAR - 9 1994

WATER RESOURCES DEPT.
SALEM, OREGON

SUBURBAN EAST SALEM WATER DISTRICT

PRODUCTION WELL NO. 4 A

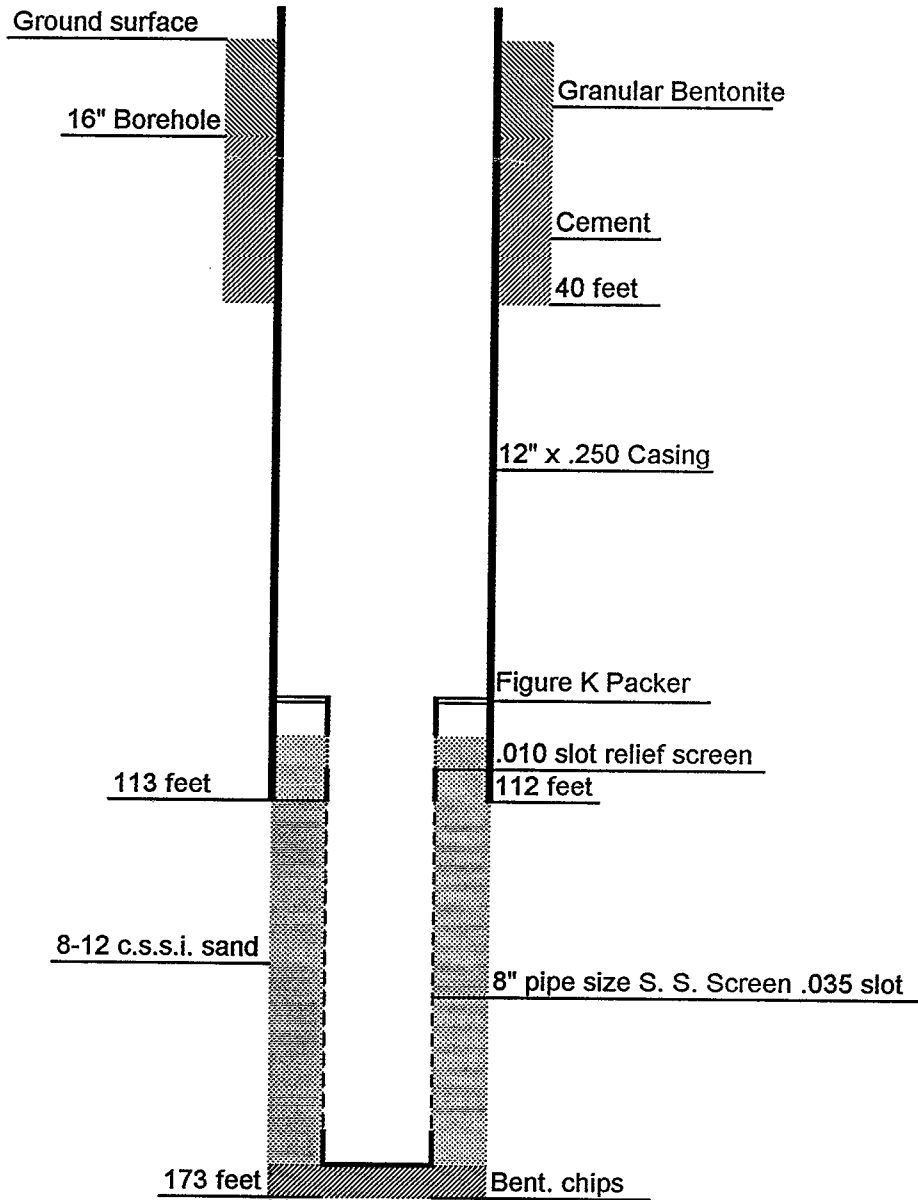

NOT TO SCALE

MARI 18908

For Official Use Only:

Received Date:

County Well Log ID #

Well Identification Tag #

MARI 18908

37891

WELL IDENTIFICATION APPLICATION FORM

Michael J. Kurtz Manager

BUYER/CURRENT WELL OWNER:

RECEIVED

Name: Suburban East Salem Water District

USER ID 12466

DEC 14 1999

Mailing Address: 3805 LaBranch Street SE

WATER RESOURCES DEPT. SALEM, OREGON

City: Salem

State: Oregon Zip: 97301

Phone: (503) 364-1620

WELL LOCATION:

MARI 18908

County: Marion

Owner's Well Number: Well 4

Township: 7 N or (S) Range: 2 E or (W) Section: 30 NW 1/4 NE 1/4

Tax Lot Number: 5703 Type of Well: water supply Domestic monitoring

ORS 264

Street Address of Well (if different from above): 4239 Craig Lane SE Salem, OR

WELL INFORMATION: (do not complete remainder of application if well log is available)

WELL LOG ATTACHED

Start Card Number: Approx. Construction Date:

Well Constructor:

Name of Owner at Time of Construction:

Well Depth (in feet): Static Water Level (in feet):

Diameter of Exposed Well Casing (in inches):

Does this well have a formal water right associated with it? Yes: No:

If Yes: Application #: Permit #: Certificate #:

Please Return Completed Form to:

Larry D. McQueen Well Identification Program Oregon Water Resources Department 158 12th Street NE Salem, OR 97310