

STATE ENGINEER
Salem, Oregon

MAR 1891

Well Record


STATE WELL NO. 5/1W-19B(1)
COUNTY Marion
APPLICATION NO. G-99

OWNER: William Stach
MAILING ADDRESS: 1027 Williams

LOCATION OF WELL: Owner's No. _____
CITY AND STATE: Woodburn, Oregon

NW 1/4 NE 1/4 Sec. 19 T. 5 N. S. R. 1 W., W.M.

Bearing and distance from section or subdivision corner
129 feet south and 2102 feet west of the ne corner of Sec. 19

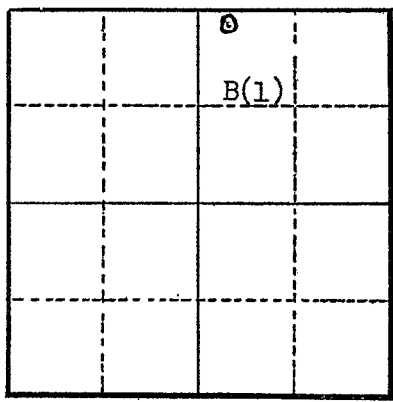

Section 19

Altitude at well 180 feet Interpolated

TYPE OF WELL: Drilled Date Constructed Sept. '55

Depth drilled 142 Depth cased 142

CASING RECORD:

8 inch, set from 0 to 142 feet

FINISH:

Perforated from 119 to 142 feet

AQUIFERS:

Sand and gravel from 112 to 123 feet, 129 to 130 feet and from 140 to 142 feet

WATER LEVEL:

36 feet below land surface, September 1955

PUMPING EQUIPMENT: Type Turbine H.P. _____
Capacity _____ G.P.M.

WELL TESTS:

Drawdown 47 ft. after 6 hours pumping 393 G.P.M.
Drawdown _____ ft. after _____ hours _____ G.P.M.

USE OF WATER Irrigation Temp. 54 °F. September 1955

SOURCE OF INFORMATION Well Drillers report

DRILLER or DIGGER Orville Wymore

ADDITIONAL DATA:

Log Water Level Measurements _____ Chemical Analysis _____ Aquifer Test _____

REMARKS: Well test

GPM	pumping level	time
393	83	6
316	75	7
280	70	7 1/2
230	64	8
185	59	8 1/2

