

STATE ENGINEER
Salem, Oregon

1901
MAR 11 1953

Well Record

STATE WELL NO. 5/1W-19M (1)
COUNTY Marion
APPLICATION NO. GR-1383

GR- 1340

OWNER: Harvey Chacin


MAILING ADDRESS: Rt. 2, Box 307

LOCATION OF WELL: Owner's No. #1

CITY AND STATE: Woodburn, Oregon

NW 1/4 SW 1/4 Sec. 19 T. 5 N. S., R. 1 W., W.M.

Bearing and distance from section or subdivision corner 1375' N. & 485' E. from SW cor. Sec. 19

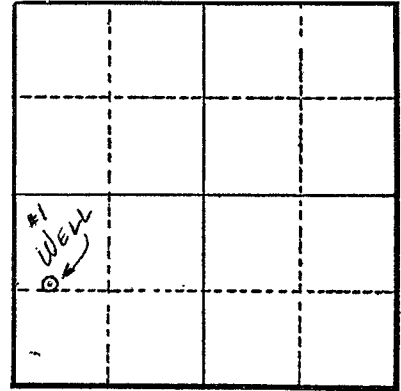

Section 19

Altitude at well 199

TYPE OF WELL: Drilled Date Constructed 1953

Depth drilled 245 ft. Depth cased 201 ft.

CASING RECORD:

8 inch

FINISH:

Perforated: from 112 to 133 ft.
from 155 to 163 ft.
from 185 to 200 ft.

AQUIFERS:

WATER LEVEL:

25 ft. (3-10-53)

PUMPING EQUIPMENT: Type Jacuzzi 8 in. turbine H.P. 15
Capacity 300 G.P.M.

WELL TESTS:

Drawdown 21 ft. after _____ hours 400 G.P.M.
Drawdown _____ ft. after _____ hours _____ G.P.M.

USE OF WATER Irrigation Temp. _____ °F. 19

SOURCE OF INFORMATION G. R. Record

DRILLER or DIGGER _____

ADDITIONAL DATA:

Log Water Level Measurements _____ Chemical Analysis _____ Aquifer Test _____

REMARKS:

Irrigation of 73.32 acres.

