

STATE ENGINEER
Salem, Oregon

1902
MARI.....

Well Record


STATE WELL NO. 5/1W-19M(2)
COUNTY Marion
APPLICATION NO. GR-901

OWNER: John A. Moron
MAILING ADDRESS: 925 Dearborn Avenue

LOCATION OF WELL: Owner's No. _____
CITY AND STATE: Salem, Oregon

NW 1/4 SW 1/4 Sec. 19 T. 5 N. S., R. 1 W., W.M.

Bearing and distance from section or subdivision
corner 750' E. & 300' S. from W 1/4 cor., Sec. 19

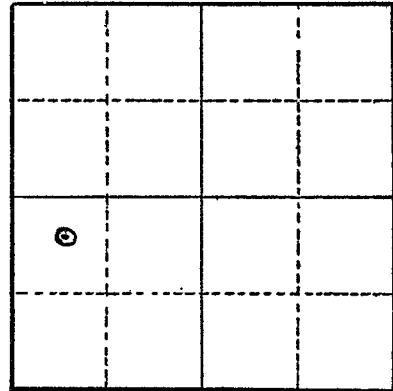

Section 19

Altitude at well 174' 180

TYPE OF WELL: Drilled Date Constructed May '47

Depth drilled 147 Depth cased 147

CASING RECORD:

10" standard thread & collar pipe 0 to 147 feet

FINISH:

Drive shoe at 147'
24 perforations madew/star perforator

AQUIFERS:

Sand and gravel 122 to 147 feet

WATER LEVEL:

35 feet (5-1-47)

PUMPING EQUIPMENT: Type Layne & Bowler lineshaft turbine H.P. 15 Elec.
Capacity 200 G.P.M. 1750 RPM GE

WELL TESTS:

Drawdown 35 ft. after _____ hours 400 G.P.M.
Drawdown _____ ft. after _____ hours _____ G.P.M.

USE OF WATER Irrigation 24 acres Temp. _____ °F. 19

SOURCE OF INFORMATION owner

DRILLER or DIGGER Max Wymore Willamette Drilling Company

ADDITIONAL DATA:

Log Water Level Measurements _____ Chemical Analysis _____ Aquifer Test _____

REMARKS:

