

STATE ENGINEER  
Salem, Oregon

1964  
MARI.....

# Well Record


STATE WELL NO. 5/1W-19R(1)  
COUNTY Marion  
APPLICATION NO. G 2348

OWNER: Frank Kahut MAILING ADDRESS:

LOCATION OF WELL: Owner's No. CITY AND STATE:

..... 1/4 ..... 1/4 Sec. ..... T. ..... N. E. S., R. ..... W., W.M.

Bearing and distance from section or subdivision corner

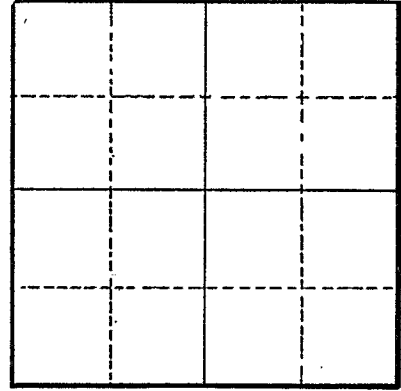

Section

Altitude at well 178

TYPE OF WELL: Drilled Date Constructed 1960

Depth drilled 137 Depth cased

### CASING RECORD:

6 inch

### FINISH:

### AQUIFERS:

Gravel

### WATER LEVEL:

22 feet below land surface on June 13, 1960

PUMPING EQUIPMENT: Type Turbine H.P. 40  
Capacity G.P.M.

### WELL TESTS:

Drawdown ..... ft. after ..... hours ..... G.P.M.  
Drawdown ..... ft. after ..... hours ..... G.P.M.

USE OF WATER Irrigation-120 acres Temp. °F., 19

SOURCE OF INFORMATION USGS

DRILLER or DIGGER

### ADDITIONAL DATA:

Log Water Level Measurements Chemical Analysis Aquifer Test

### REMARKS: